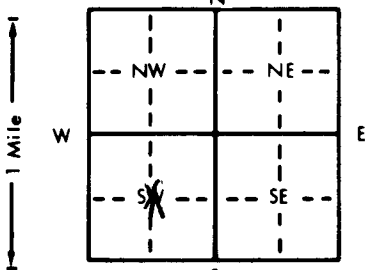


1 LOCATION OF WATER WELL: County: Pratt Fraction 1/4 N/C 1/4 SW 1/4 Section Number 12 Township Number T 27 S Range Number R 13 XE/W

Distance and direction from nearest town or city street address of well if located within city?
1 1/4 south, 1 1/4 east of Iuka, Ks.

2 WATER WELL OWNER: Don Hullman
 RR#, St. Address, Box #: 30215 NE 20th Ave Board of Agriculture, Division of Water Resources
 City, State, ZIP Code: Pratt, Ks. 67124 Application Number:

3 LOCATE WELL'S LOCATION WITH AN "X" IN SECTION BOX:

 4 DEPTH OF COMPLETED WELL: 131 ft. ELEVATION:
 Depth(s) Groundwater Encountered 1. ft. 2. ft. 3. ft.
 WELL'S STATIC WATER LEVEL: 35' 9" ft. below land surface measured on mo/day/yr 3-2-99
 Pump test data: Well water was ft. after hours pumping gpm
 Est. Yield na gpm: Well water was ft. after hours pumping gpm
 Bore Hole Diameter: 7 in. to 135 ft., and in. to ft.
 WELL WATER TO BE USED AS:
 1 Domestic 3 Feedlot 6 Oil field water supply 9 Dewatering 12 Other (Specify below) test hole
 2 Irrigation 4 Industrial 7 Lawn and garden only 10 Monitoring well
 Was a chemical/bacteriological sample submitted to Department? Yes X No If yes, mo/day/yr sample was submitted 3-2-99
 Water Well Disinfected? Yes No X

5 TYPE OF BLANK CASING USED:
 1 Steel 3 RMP (SR) 5 Wrought iron 8 Concrete tile CASING JOINTS: Glued X Clamped
 2 PVC 4 ABS 6 Asbestos-Cement 9 Other (specify below) Welded
 7 Fiberglass Threaded
 Blank casing diameter 3 in. to 126 ft., Dia. in. to ft., Dia. in. to ft.
 Casing height above land surface 24 in., weight sch 80 lbs./ft. Wall thickness or gauge No.
 TYPE OF SCREEN OR PERFORATION MATERIAL:
 1 Steel 3 Stainless steel 5 Fiberglass 8 RMP (SR) 10 Asbestos-cement 11 Other (specify)
 2 Brass 4 Galvanized steel 6 Concrete tile 9 ABS 12 None used (open hole)
 SCREEN OR PERFORATION OPENINGS ARE:
 1 Continuous slot 3 Mill slot 5 Gauzed wrapped 8 ~~Saw-cut~~ 11 None (open hole)
 2 Louvered shutter 4 Key punched 6 Wire wrapped 9 Drilled holes
 7 Torch cut 10 Other (specify)
 SCREEN-PERFORATED INTERVALS: From 126 ft. to 131 ft., From ft. to ft.
 From ft. to ft., From ft. to ft.
 GRAVEL PACK INTERVALS: From 135 ft. to 119 ft., From ft. to ft.
 From ft. to ft., From ft. to ft.

6 GROUT MATERIAL: 1 Neat cement 2 ~~Cement~~ grout 3 Bentonite 4 Other hole plug 23'-0" 119'-117'
 Grout Intervals: From 117 ft. to 23 ft., From ft. to ft., From ft. to ft.
 What is the nearest source of possible contamination:
 1 Septic tank 4 Lateral lines 7 Pit privy 10 Livestock pens 14 Abandoned water well
 2 Sewer lines 5 Cess pool 8 Sewage lagoon 11 Fuel storage 15 ~~Oil well~~ Gas well
 3 Watertight sewer lines 6 Seepage pit 9 Feedyard 12 Fertilizer storage 16 Other (specify below)
 13 Insecticide storage
 Direction from well? south How many feet? 900'

FROM	TO	LITHOLOGIC LOG	FROM	TO	PLUGGING INTERVALS
0	3	Sandy top soil	86	103	Sandy white & brown clay
3	8	Gray clay			and fine sand
8	15	Brown clay	103	117	Sand & gravel medium loose & clean
15	18	Sandy brown clay & sand mixed			
18	31	Sand and gravel	117	118	White clay
31	40	Sandy brown clay	118	131	Sand & gravel loose medium clean
40	48	Sand & gravel medium loose			
48	51	Brown clay & sand mixed	131	132	Blue gray clay
51	60	Sand & gravel loose, medium	132	135	Red bed
60	65	Brown & white clay			
65	71	Sand & gravel medium loose			
71	73	Brown clay			
73	74 1/2	Fine sand			
74 1/2	85	Reddish brown & white clay			
85	86	Hard white rock			

7 CONTRACTOR'S OR LANDOWNER'S CERTIFICATION: This water well was (1) constructed, (2) reconstructed, or (3) plugged under my jurisdiction and was completed on (mo/day/year) 3-2-99 and this record is true to the best of my knowledge and belief. Kansas Water Well Contractor's License No. 134 This Water Well Record was completed on (mo/day/yr) 3-3-99
 under the business name of Rosencrantz-Bemis by (signature) Media Hullman

OFFICE USE ONLY

T

R

EW

SEC.

1/4

1/4

1/4