


Sheet 16

1 LOCATION OF WATER WELL: Fraction NE 1/4 SE 1/4 NW 1/4 Section Number 03 Township Number T 27 S Range Number R 13 EW
 County: PRATT
 Distance and direction from nearest town or city street address of well if located within city?
MAIN & SUMNER, LUKE, KS

2 WATER WELL OWNER: LUKE COOP
 RR#, St. Address, Box #: Box 175 Board of Agriculture, Division of Water Resources
 City, State, ZIP Code: LUKE, KS 67066 Application Number:

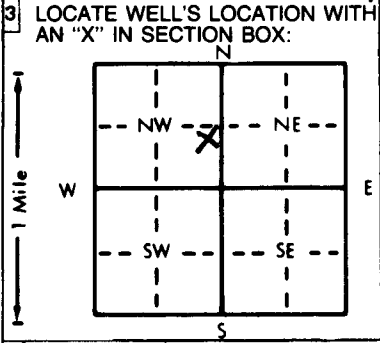

4 DEPTH OF COMPLETED WELL: 55 ft. ELEVATION: 1942.42
 Depth(s) Groundwater Encountered 1. 248 ft. 2. ft. 3. ft.
 WELL'S STATIC WATER LEVEL 48.91 ft. below land surface measured on mo/day/yr 5/3/00
 Pump test data: Well water was ft. after hours pumping gpm
 Est. Yield gpm: Well water was ft. after hours pumping gpm
 Bore Hole Diameter: 10.25 in. to 60 ft., and in. to ft.
 WELL WATER TO BE USED AS: 5 Public water supply 8 Air conditioning 11 Injection well
 1 Domestic 3 Feedlot 6 Oil field water supply 9 Dewatering 12 Other (Specify below)
 2 Irrigation 4 Industrial 7 Lawn and garden only 10 Monitoring well VAPOR EXTRACTION
 Was a chemical/bacteriological sample submitted to Department? Yes No X: If yes, mo/day/yr sample was submitted
 Water Well Disinfected? Yes No

5 TYPE OF BLANK CASING USED:
 1 Steel 3 RMP (SR) 5 Wrought iron 8 Concrete tile CASING JOINTS: Glued Clamped
2 PVC 4 ABS 6 Asbestos-Cement 9 Other (specify below) Welded
 Blank casing diameter 4 in. to 40 ft., Dia. in. to ft., Dia. in. to in. to ft.
 Casing height above land surface: -4.92 in., weight lbs./ft. Wall thickness or gauge No. SCH40
 TYPE OF SCREEN OR PERFORATION MATERIAL:
 1 Steel 3 Stainless steel 5 Fiberglass 7 PVC 10 Asbestos-cement
 2 Brass 4 Galvanized steel 6 Concrete tile 9 ABS 11 Other (specify)
 12 None used (open hole)
 SCREEN OR PERFORATION OPENINGS ARE:
 1 Continuous slot 3 Mill slot 5 Gauzed wrapped 8 Saw cut 11 None (open hole)
 2 Louvered shutter 4 Key punched 6 Wire wrapped 9 Drilled holes
 7 Torch cut 10 Other (specify)
 SCREEN-PERFORATED INTERVALS: From 40 ft. to 55 ft., From ft. to ft.
 From ft. to ft., From ft. to ft.
 GRAVEL PACK INTERVALS: From 30 ft. to 60 ft., From ft. to ft.
 From ft. to ft., From ft. to ft.

6 GROUT MATERIAL: 1 Neat cement 2 Cement grout 3 Bentonite 4 Other
 Grout Intervals: From 3 ft. to 32 ft. From 32 ft. to 36 ft. From ft. to ft.
 What is the nearest source of possible contamination:
 1 Septic tank 4 Lateral lines 7 Pit privy 10 Livestock pens 14 Abandoned water well
 2 Sewer lines 5 Cess pool 8 Sewage lagoon 11 Fuel storage 15 Oil well/Gas well
 3 Watertight sewer lines 6 Seepage pit 9 Feedyard 12 Fertilizer storage 16 Other (specify below)
13 Insecticide storage DUST SITE
 Direction from well? How many feet?

FROM	TO	LITHOLOGIC LOG	FROM	TO	PLUGGING INTERVALS
0	9	CLAY			
9	12	SAND			
12	31	CLAY			
31	38	SILT			
38	53	SILT SANDY			
53	60	SAND			

7 CONTRACTOR'S OR LANDOWNER'S CERTIFICATION: This water well was (1) constructed, (2) reconstructed, or (3) plugged under my jurisdiction and was completed on (mo/day/year) 4/11/06 and this record is true to the best of my knowledge and belief. Kansas Water Well Contractor's License No. 504 This Water Well Record was completed on (mo/day/year) 4/17/06 under the business name of CORANCO GREAT PLAINS by (signature) [Signature]