

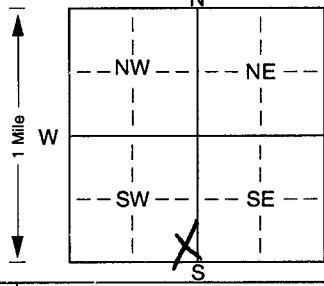
007263

WATER WELL RECORD

Form WWC-5

KSA 82a-1212 ID No.

CM2533

1 LOCATION OF WATER WELL:		Fraction	Section Number	Township Number	Range Number
County: Pratt		SE 1/4 SE 1/4 SW 1/4	34	T 27 S	R 13 W
Distance and direction from nearest town or city street address of well if located within city? 701 E 13th Pratt					
2 WATER WELL OWNER:		Board of Agriculture, Division of Water Resources			
RR#, St. Address, Box #		Application Number:			
City, State, ZIP Code		Houston TX 77046			
3 LOCATE WELL'S LOCATION WITH AN "X" IN SECTION BOX:		4 DEPTH OF COMPLETED WELL: 35 ft. ELEVATION:			
		Depth(s) Groundwater Encountered 1. ft. 2. ft. 3. ft. WELL'S STATIC WATER LEVEL ft. below land surface measured on mo/day/yr Pump test data: Well water was ft. after hours pumping gpm Est. Yield gpm: Well water was ft. after hours pumping gpm Bore Hole Diameter. 8.5 in. to 35 ft., and in. to ft. WELL WATER TO BE USED AS: 5 Public water supply 8 Air conditioning 11 Injection well 1 Domestic 3 Feedlot 6 Oil field water supply 9 Dewatering 12 Other (Specify below) 2 Irrigation 4 Industrial 7 Domestic (lawn & garden) 10 Monitoring well MW-3			
		Was a chemical/bacteriological sample submitted to Department? Yes. No. X; If yes, mo/day/yr sample was submitted Water Well Disinfected? Yes No X			
5 TYPE OF BLANK CASING USED:		CASING JOINTS: Glued. Clamped.			
1 Steel 2 PVC		3 RMP (SR) 4 ABS 5 Wrought iron 6 Asbestos-Cement 7 Fiberglass 8 Concrete tile 9 Other (specify below) Welded Threaded Flush			
Blank casing diameter 2 in. to 25 ft., Dia in. to ft., Dia in. to ft.		Casing height above land surface. Flush in., weight 203 lbs./ft. Wall thickness or gauge No. Sch 40			
TYPE OF SCREEN OR PERFORATION MATERIAL:		7 PVC 10 Asbestos-cement 11 Other (specify) 12 None used (open hole)			
1 Steel 2 Brass 3 Stainless steel 4 Galvanized steel 5 Fiberglass 6 Concrete tile 8 RMP (SR) 9 ABS		SCREEN OR PERFORATION OPENINGS ARE: 1 Continuous slot 2 Louvered shutter 3 Mill slot 4 Key punched 5 Gauzed wrapped 6 Wire wrapped 7 Torch cut 8 Saw cut 9 Drilled holes 10 Other (specify) ft. 11 None (open hole)			
SCREEN-PERFORATED INTERVALS: From 25 ft. to 35 ft., From ft. to ft.		GRAVEL PACK INTERVALS: From 20 ft. to 35 ft., From ft. to ft.			
6 GROUT MATERIAL:		3 Bentonite 4 Other			
1 Neat cement 2 Cement grout		Grout Intervals: From 2 ft. to 20 ft., From ft. to ft., From ft. to ft.			
What is the nearest source of possible contamination:		10 Livestock pens 11 Fuel storage 12 Fertilizer storage 13 Insecticide storage 14 Abandoned water well 15 Oil well/Gas well 16 Other (specify below)			
1 Septic tank 2 Sewer lines 3 Watertight sewer lines 4 Lateral lines 5 Cess pool 6 Seepage pit 7 Pit privy 8 Sewage lagoon 9 Feedyard		Direction from well? How many feet?			
FROM	TO	LITHOLOGIC LOG	FROM	TO	PLUGGING INTERVALS
0	5	Sandy clay			
5	6	clay-sand			
6	10	Sandy clay			
10	35	sand			
7 CONTRACTOR'S OR LANDOWNER'S CERTIFICATION: This water well was (1) constructed, (2) reconstructed, or (3) plugged under my jurisdiction and was completed on (mo/day/year) 12/13/00 and this record is true to the best of my knowledge and belief. Kansas Water Well Contractor's Licence No. 531 This Water Well Record was completed on (mo/day/yr) 11/11/01 under the business name of Geotechnical Services, Inc. by (signature) Alvin M. Smith					
INSTRUCTIONS: Use typewriter or ball point pen. PLEASE PRESS FIRMLY and PRINT clearly. Please fill in blanks, underline or circle the correct answers. Send top three copies to Kansas Department of Health and Environment, Bureau of Water, Topeka, Kansas 66620-0001. Telephone 785-296-5524. Send one to WATER WELL OWNER and retain one for your records. Fee of \$5.00 for each constructed well.					