

CORRECTION TO WATER WELL RECORD (WWC-5)

The following correction(s) was made to the attached WWC-5 log, in order to file the item or to rectify lacking or incorrect information.

Fraction ( 1/4 1/4 1/4) Section-Township-Range changed:

listed as SE SE SE, 31 — 27-28S — 13E

changed to SW SW NE, 31-27S-13W

Other changes: Initial statements: \_\_\_\_\_

Changed to: \_\_\_\_\_


Comments: \_\_\_\_\_

verification method: Well owner's address, area map on internet, and legal description, and Coats NE 1:24,000 topo map initials: DRD date: 4/29/2001  
(Buildings shown on map)

submitted by: Kansas Geological Survey, Data Resources Library, 1930 Constant Ave., Lawrence, KS 66047-3726  
to: Kansas Dept of Health & Environment Bureau of Water Industrial Programs, Bldg 283, Forbes Field, KS 66620

1] LOCATION OF WATER WELL: Fraction SE 1/4 SE 1/4 SE 1/4 Section Number 31 Township Number T 27 28 S Range Number R 13 E EW  
 County: Pratt  
 Distance and direction from nearest town or city street address of well if located within city?

2] WATER WELL OWNER: Brad Swisher  
 RR#, St. Address, Box # : 20278 NW 10th/ Street Board of Agriculture, Division of Water Resources  
 City, State, ZIP Code : Pratt Ks 67124 Application Number:

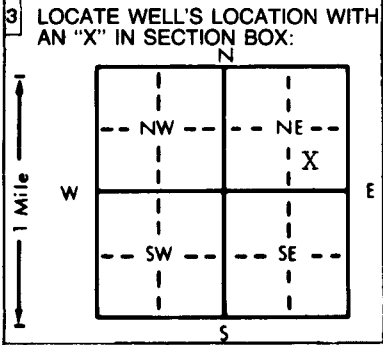

4] DEPTH OF COMPLETED WELL 96 ft. ELEVATION: .....  
 Depth(s) Groundwater Encountered 1. .... ft. 2. .... ft. 3. .... ft.  
 WELL'S STATIC WATER LEVEL N/A ft. below land surface measured on mo/day/yr  
 Pump test data: Well water was ..... ft. after ..... hours pumping ..... gpm  
 Est. Yield ..... gpm: Well water was ..... ft. after ..... hours pumping ..... gpm  
 Bore Hole Diameter 10 inch in. to ..... ft., and ..... in. to ..... ft.  
 WELL WATER TO BE USED AS: 5 Public water supply 8 Air conditioning 11 Injection well  
 Domestic 3 Feedlot 6 Oil field water supply 9 Dewatering 12 Other (Specify below)  
 2 Irrigation 4 Industrial 7 Lawn and garden only 10 Monitoring well .....  
 Was a chemical/bacteriological sample submitted to Department? Yes.....No.....; If yes, mo/day/yr sample was submitted  
 Water Well Disinfected? Yes Yes No

5] TYPE OF BLANK CASING USED: 5 Wrought iron 8 Concrete tile CASING JOINTS: Glued ..... Clamped .....  
 1 Steel 3 RMP (SR) 6 Asbestos-Cement 9 Other (specify below) Welded .....  
 PVC 4 ABS 7 Fiberglass ..... Threaded .....  
 Blank casing diameter 5 in. to ..... ft., Dia ..... in. to ..... ft., Dia ..... in. to ..... ft.  
 Casing height above land surface 24 in., weight 160 lbs./ft. Wall thickness or gauge No. ....  
 TYPE OF SCREEN OR PERFORATION MATERIAL:  PVC 10 Asbestos-cement  
 1 Steel 3 Stainless steel 5 Fiberglass 8 RMP (SR) 11 Other (specify) .....  
 2 Brass 4 Galvanized steel 6 Concrete tile 9 ABS 12 None used (open hole)  
 SCREEN OR PERFORATION OPENINGS ARE: 5 Gauzed wrapped  Saw cut 11 None (open hole)  
 1 Continuous slot 3 Mill slot 6 Wire wrapped 9 Drilled holes  
 2 Louvered shutter 4 Key punched 7 Torch cut 10 Other (specify) .....  
 SCREEN-PERFORATED INTERVALS: From 96 ft. to 76 ft., From ..... ft. to ..... ft.  
 From ..... ft. to ..... ft., From ..... ft. to ..... ft.  
 GRAVEL PACK INTERVALS: From 96 ft. to 20 ft., From ..... ft. to ..... ft.  
 From ..... ft. to ..... ft., From ..... ft. to ..... ft.

6] GROUT MATERIAL: 1 Neat cement 2 Cement grout  Bentonite 4 Other .....  
 Grout intervals: From ..... ft. to ..... ft., From ..... ft. to ..... ft., From ..... ft. to ..... ft.  
 What is the nearest source of possible contamination:  
 1 Septic tank 4 Lateral lines 7 Pit privy 10 Livestock pens 14 Abandoned water well  
 2 Sewer lines 5 Cess pool 8 Sewage lagoon 11 Fuel storage 15 Oil well/Gas well  
 Watertight sewer lines 6 Seepage pit 9 Feedyard 12 Fertilizer storage 16 Other (specify below)  
 13 Insecticide storage .....  
 Direction from well? SW How many feet? 180

FROM	TO	LITHOLOGIC LOG	FROM	TO	PLUGGING INTERVALS
0	40	Clay			
45	50	Fine sand			
55	70	Coarsesand & gravel			
70	80	Clay			
80	96	Coarse to fine sand			
96	76	Perf			
20	0	Grout			

7] CONTRACTOR'S OR LANDOWNER'S CERTIFICATION: This water well was  constructed, (2) reconstructed, or (3) plugged under my jurisdiction and was completed on (mo/day/year) 3/3/2001 and this record is true to the best of my knowledge and belief. Kansas Water Well Contractor's License No. 672 This Water Well Record was completed on (mo/day/yr) 3/25/2001 under the business name of Crowdis Water well Service by (signature) Tom Crowdis