

1 LOCATION OF WATER WELL:	Fraction	Section Number	Township Number	Range Number
County: PRATT	SE ¼ SE ¼ SW ¼	34	T 27 S	R 13 E/W

Distance and direction from nearest town or city street address of well if located within city?

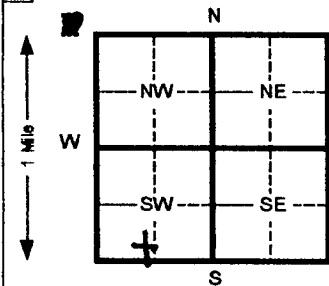
2 WATER WELL OWNER: **Delux Cleaners**RR#, St. Address, Box #: **014 East 1st St**City, State, ZIP Code: **Pratt, Ks**

MW 19 (d)

Board of Agriculture, Division of Water Resources

Application Number:

3 LOCATE WELL'S LOCATION WITH AN "X" IN SECTION BOX:

4 DEPTH OF COMPLETED WELL **165** ft. ELEVATION:

Depth(s) Groundwater Encountered 1 _____ ft. 2 _____ ft. 3 _____ ft.

WELL'S STATIC WATER LEVEL **51.85** ft. below land surface measured on mo/day/yr

Pump test data: Well water was _____ ft. after _____ hours pumping _____ gpm

Est. Yield _____ gpm: Well water was _____ ft. after _____ hours pumping _____ gpm

Bore Hole Diameter **8** in. to **165** ft. and _____ in. to _____ ft.

WELL WATER TO BE USED AS: 5 Public water supply 8 Air conditioning 11 Injection well

1 Domestic 3 Feed lot 6 Oil field water supply 9 Dewatering 12 Other (Specify below)

2 Irrigation 4 Industrial 7 Lawn and garden (domestic) **10** Monitoring wellWas a chemical/bacteriological sample submitted to Department? Yes _____ No **X** If yes, mo/day/yr sample was submittedWater Well Disinfected? Yes _____ No **X**

5 TYPE OF BLANK CASING USED:

1 Steel

3 RMP (SR)

5 Wrought Iron

8 Concrete tile

CASING JOINTS: Glued _____ Clamped _____

2 PVC

4 ABS

6 Asbestos-Cement

9 Other (specify below)

Welded _____

7 Fiberglass

Threaded **X**Blank casing diameter **4** in. to **155** ft., Dia _____ in. to _____ ft., Dia _____ in. to _____ ft.Casing height above land surface **0** in., weight _____ lbs./ft. Wall thickness or gauge No. _____

TYPE OF SCREEN OR PERFORATION MATERIAL:

1 Steel

3 Stainless steel

5 Fiberglass

7 PVC

10 Asbestos-cement

2 Brass

4 Galvanized steel

6 Concrete tile

8 RMP (SR)

11 Other (specify)

9 ABS

12 None used (open hole)

SCREEN OR PERFORATION OPENINGS ARE:

1 Continuous slot

3 Mill slot

5 Gauzed wrapped

8 Saw cut

11 None (open hole)

2 Louvered shutter

4 Key punched

6 Wire wrapped

9 Drilled holes

7 Torch cut

10 Other (specify)

SCREEN-PERFORATED INTERVALS: From **155** ft. to **165** ft. From _____ ft. to _____ ft.

From _____ ft. to _____ ft. From _____ ft. to _____ ft.

GRAVEL PACK INTERVALS: From **153** ft. to **165** ft. From _____ ft. to _____ ft.

From _____ ft. to _____ ft. From _____ ft. to _____ ft.

6 GROUT MATERIAL:

1 Neat cement

2 Cement grout

3 Bentonite

4 Other _____

Grout intervals From **0** ft. to **153** ft. From _____ ft. to _____ ft. From _____ ft. to _____ ft.

What is the nearest source of possible contamination:

1 Septic tank

4 Lateral lines

7 Pit privy

10 Livestock pens

14 Abandoned water well

2 Sewer lines

5 Cess pool

8 Sewage lagoon

11 Fuel storage

15 Oil well/ Gas well

3 Watertight sewer lines

6 Seepage pit

9 Feedyard

12 Fertilizer storage

16 Other (specify below)

13 Insecticide storage

CONTAMINATED SITE

Direction from well?

How many feet?

FROM	TO	CODE	LITHOLOGIC LOG	FROM	TO	PLUGGING INTERVALS
0	2		Asphalt			
2	31		Fine to med sand			
31	46		Clay w/med sd			
46	62		Fine to med sand & gravel w/ Clay lens			
62	101		Fine to med sand & gravel			
101	106		Fine sand w/sandy clay str			
106	128		Fine to med sand w/clay str			
128	146		Clay w/med sand lens			
146	154		Fine sand w/sandy clay str			
154	165		Clay			
165			Reddish shale			

7 CONTRACTOR'S OR LANDOWNER'S CERTIFICATION: This water well was (1) constructed, (2) reconstructed, or (3) plugged under my jurisdiction and wascompleted on (mo/day/yr) **3-30-01** and this record is true to the best of my knowledge and belief. KansasWater Well Contractor's License No. **554** This Water Well Record was completed on (mo/day/yr) **4-9-01**under the business name of **Woofter Pump and Well Inc.** by (signature) *Jay E. Woofter*

INSTRUCTIONS: Please fill in blanks and circle the correct answers. Send three copies to Kansas Department of Health and Environment, Bureau of Water, Topeka, Kansas 66620-0001. Telephone: 913-296-5545. Send one to WATER WELL OWNER and retain one for your records.