


1 LOCATION OF WATER WELL: Fraction NE 1/4 SE 1/4 NW 1/4 Section Number 3 Township Number T 27 S Range Number R 13 **EW**

Distance and direction from nearest town or city street address of well if located within city?
SW Corner of East Elevator

2 WATER WELL OWNER: Iuka Coop
 RR#, St. Address, Box #: Box 175
 City, State, ZIP Code: Iuka, KS 68179 Board of Agriculture, Division of Water Resources
 Application Number: MW-10D

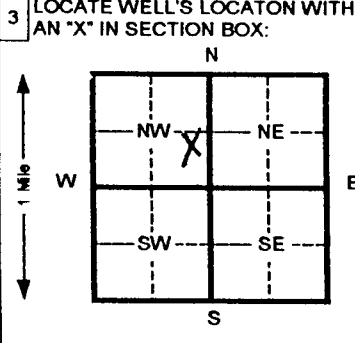

4 DEPTH OF COMPLETED WELL 220 ft. ELEVATION: _____ ft.

Depth(s) Groundwater Encountered 1 _____ ft. 2 _____ ft. 3 _____ ft.

WELL'S STATIC WATER LEVEL 50 ft. below land surface measured on mo/day/yr

Pump test data: Well water was _____ ft. after _____ hours pumping _____ gpm

Est. Yield _____ gpm: Well water was _____ ft. after _____ hours pumping _____ gpm

Bore Hole Diameter 8 in. to 220 ft. and _____ in. to _____ ft.

WELL WATER TO BE USED AS: 5 Public water supply 8 Air conditioning 11 Injection well
 1 Domestic 3 Feed lot 6 Oil field water supply 9 Dewatering 12 Other (Specify below)

2 Irrigation 4 Industrial 7 Lawn and garden (domestic) 10 Monitoring well

Was a chemical/bacteriological sample submitted to Department? Yes _____ No If yes, mo/day/yr sample was submitted _____

Water Well Disinfected? Yes _____ No

5 TYPE OF BLANK CASING USED:

1 Steel 3 RMP (SR) 5 Wrought Iron 8 Concrete tile CASING JOINTS: Glued _____ Clamped _____
 2 PVC 4 ABS 6 Asbestos-Cement 9 Other (specify below) Welded _____
 7 Fiberglass _____ Threaded X

Blank casing diameter 4 in. to 200 ft. Dia _____ in. to _____ ft. Dia _____ in. to _____ ft.

Casing height above land surface 0 in., weight 2.071 lbs./ft. Wall thickness or gauge No. 237

TYPE OF SCREEN OR PERFORATION MATERIAL:

1 Steel 3 Stainless steel 5 Fiberglass 8 RMP (SR) 10 Asbestos-cement
 2 Brass 4 Galvanized steel 6 Concrete tile 9 ABS 11 Other (specify) _____
 12 None used (open hole)

SCREEN OR PERFORATION OPENINGS ARE:

1 Continuous slot 3 Mill slot 5 Gauzed wrapped 8 Saw cut 11 None (open hole)
 2 Louvered shutter 4 Key punched 6 Wire wrapped 9 Drilled holes
 7 Torch cut 10 Other (specify) _____

SCREEN-PERFORATED INTERVALS: From 200 ft. to 220 ft. From _____ ft. to _____ ft.
 From _____ ft. to _____ ft. From _____ ft. to _____ ft.

GRAVEL PACK INTERVALS: From 197 ft. to 220 ft. From _____ ft. to _____ ft.
 From _____ ft. to _____ ft. From _____ ft. to _____ ft.

6 GROUT MATERIAL: 1 Neat cement 2 Cement grout 3 Bentonite 4 Other _____

Grout Intervals From 0 ft. to 194 ft. From 194 ft. to 197 ft. From _____ ft. to _____ ft.

What is the nearest source of possible contamination:

1 Septic tank 4 Lateral lines 7 Pit privy 10 Livestock pens 14 Abandoned water well
 2 Sewer lines 5 Cess pool 8 Sewage lagoon 11 Fuel storage 15 Oil well/ Gas well
 3 Watertight sewer lines 6 Seepage pit 9 Feedyard 12 Fertilizer storage 16 Other (specify below) **CONTAMINATED SITE**

Direction from well? _____ How many feet? _____

FROM	TO	CODE	LITHOLOGIC LOG	FROM	TO	PLUGGING INTERVALS
0	0.5		Sand, crushed rock, fill	219	220	Shale, very silty, hard
0.5	2		Silt, sandy, gravel, fill			
2	40		Silty clay, sand clay streaks			
40	46		Sandy clay, fine, clay streaks			
46	60		Sand, fine to med, clayey			
60	155		Sand, fine to med, some coarse			
155	159		Sandy clay			
159	170		Sand, med to coarse, small gravel			
170	174		Sandy clay			
174	186		Sand, med to coarse, large gravel			
186	192		Sandy clay			
192	212		Sand, med to coarse, gravel			
212	216		Sandy Clay			
216	219		Sand, med coarse, hard cent			

7 CONTRACTOR'S OR LANDOWNER'S CERTIFICATION: This water well was (1) constructed, (2) reconstructed, or (3) plugged under my jurisdiction and was completed on (mo/day/yr) 7-12-01 and this record is true to the best of my knowledge and belief. Kansas Water Well Contractor's License No. 554 This Water Well Record was completed on (mo/day/yr) 8-14-01 under the business name of Woofter Pump and Well Inc by (signature) [Signature]

OFFICE USE ONLY

T

R

SEC