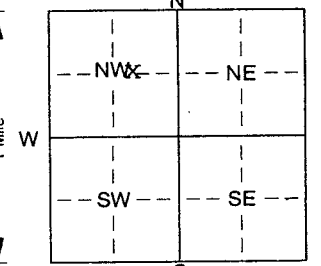


LOCATION OF WATER WELL: County: Pratt	Fraction SW ¼ NE ¼ NW ¼	Section Number 3	Township Number T 27 S	Range Number R 13W EW
--	----------------------------	---------------------	---------------------------	--------------------------

Distance and direction from nearest town or city street address of well if located within city?

210 West Sumner Ave Iuka

WATER WELL OWNER: JA Starrett	Board of Agriculture, Division of Water Resources
RR#, St. Address, Box #: 210 West Sumner Ave	Application Number:
City, State, ZIP Code: Iuka, KS 67066	

LOCATE WELL'S LOCATION WITH AN "X" IN SECTION BOX: 	DEPTH OF COMPLETED WELL: ft. ELEVATION: ft.
	Depth(s) Groundwater Encountered 1. ft. 2. ft. 3. ft. WELL'S STATIC WATER LEVEL ft. below land surface measured on mo/day/yr Pump test data: Well water was ft. after hours pumping gpm Est. Yield gpm: Well water was ft. after hours pumping gpm Bore Hole Diameter in. to ft., and in. to ft. WELL WATER TO BE USED AS: 5 Public water supply 8 Air conditioning 11 Injection well 1 Domestic 3 Feedlot 6 Oil field water supply 9 Dewatering 12 Other (Specify below) 2 Irrigation 4 Industrial 7 Domestic (lawn & garden) 10 Monitoring well Was a chemical/bacteriological sample submitted to Department? Yes. No.; If yes, mo/day/yrs sample was submitted Water Well Disinfected? Yes No

TYPE OF BLANK CASING USED:	5 Wrought iron	8 Concrete tile	CASING JOINTS: Glued. Clamped.
1 Steel	3 RMP (SR)	6 Asbestos-Cement	9 Other (specify below) Welded.
2 PVC	4 ABS	7 Fiberglass	Threaded.
Blank casing diameter . . 5 in. to 6 ft., Dia in. to ft., Dia in. to ft.			
Casing height above land surface. . . 16 in., weight SDR . 21 lbs./ft. Wall thickness or gauge No.			
TYPE OF SCREEN OR PERFORATION MATERIAL:	5 Fiberglass	8 RMP (SR)	10 Asbestos-cement
1 Steel	3 Stainless steel	6 Concrete tile	9 ABS
2 Brass	4 Galvanized steel	7 Torch cut	11 Other (specify)
SCREEN OR PERFORATION OPENINGS ARE:	5 Gauzed wrapped	8 Saw cut	11 None (open hole)
1 Continuous slot	3 Mill slot	9 Drilled holes	
2 Louvered shutter	4 Key punched	10 Other (specify)	
SCREEN-PERFORATED INTERVALS: From ft. to ft., From ft. to ft., From ft. to ft.			
GRAVEL PACK INTERVALS: From ft. to ft., From ft. to ft., From ft. to ft.			

GROUT MATERIAL:	1 Neat cement	2 Cement grout	3 Bentonite	4 Other
GROUT INTERVALS: From . 4 ft. to 6 ft., From ft. to ft., From ft. to ft.				
What is the nearest source of possible contamination:	10 Livestock pens	14 Abandoned water well		
1 Septic tank	4 Lateral lines	7 Pit privy	11 Fuel storage	15 Oil well/Gas well
2 Sewer lines	5 Cess pool	8 Sewage lagoon	12 Fertilizer storage	16 Other (specify below)
3 Watertight sewer lines	6 Seepage pit	9 Feedyard	13 Insecticide storage	
Direction from well?			How many feet?	

FROM	TO	LITHOLOGIC LOG	FROM	TO	PLUGGING INTERVALS
		Well was in a pit. We Attached 5" PVC to 5" Steel Casing 6' Below ground level and extended the PVC up to 16" above ground level. We Grouted from 6' to 4'. Installed Pittless adaptor at 4' Filled in pit with clay and installed sanitary well seal.			

CONTRACTOR'S OR LANDOWNER'S CERTIFICATION: This water well was (1) constructed, (2) reconstructed, or (3) plugged under my jurisdiction and was completed on (mo/day/year) . . . 12-10-01 and this record is true to the best of my knowledge and belief. Kansas Water Well Contractor's Licence No. . . . 677 This Water Well Record was completed on (mo/day/yr) . 12-17-01 under the business name of CLT Inc by (signature) <i>[Signature]</i>
--