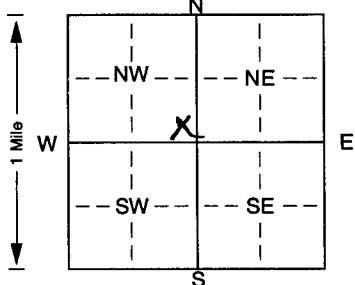


1 LOCATION OF WATER WELL: County: <u>Protte</u>	Fraction <u>SE 1/4 SE 1/4 NW 1/4</u>	Section Number <u>3</u>	Township Number T <u>27</u> S	Range Number R <u>15</u> <u>EW</u>
--	---	----------------------------	----------------------------------	---------------------------------------

Distance and direction from nearest town or city street address of well if located within city?
Main & Summer Iuka Kansas 67066

2 WATER WELL OWNER: Iuka Coop
RR#, St. Address, Box #: P.O. Box 175
City, State, ZIP Code: Iuka Kansas 67066
Board of Agriculture, Division of Water Resources
Application Number:

3 LOCATE WELL'S LOCATION WITH AN "X" IN SECTION BOX:


4 DEPTH OF COMPLETED WELL: 69.5 ft. ELEVATION: 1944.57
Depth(s) Groundwater Encountered 1. 1.48 ft. 2. ft. 3. ft.
WELL'S STATIC WATER LEVEL: 46.21 ft. below land surface measured on mo/day/yr 11/6/02
Pump test data: Well water was ft. after hours pumping gpm
Est. Yield gpm: Well water was ft. after hours pumping gpm
Bore Hole Diameter: 8.25 in. to 7.0 in. to in. to ft.
WELL WATER TO BE USED AS:
5 Public water supply 8 Air conditioning 11 Injection well
1 Domestic 3 Feedlot 6 Oil field water supply 9 Dewatering 12 Other (Specify below)
2 Irrigation 4 Industrial 7 Domestic (lawn & garden) 10 Monitoring well
Was a chemical/bacteriological sample submitted to Department? Yes. No X; If yes, mo/day/yr sample was submitted
Water Well Disinfected? Yes No

5 TYPE OF BLANK CASING USED:
1 Steel 3 RMP (SR) 5 Wrought iron 8 Concrete tile CASING JOINTS: Glued. Clamped.
2 Brass 4 Galvanized steel 6 Asbestos-Cement 9 Other (specify below) Welded.
3 Stainless steel 7 Fiberglass Threaded PVC
Blank casing diameter: 10 1/2 in. to 6.7 ft., Dia. in. to ft., Dia. in. to ft.
Casing height above land surface: 38.76 in., weight 0.8 lbs./ft. Wall thickness or gauge No. SCH40
TYPE OF SCREEN OR PERFORATION MATERIAL:
1 Steel 3 Stainless steel 5 Fiberglass 8 RMP (SR) 10 Asbestos-cement
2 Brass 4 Galvanized steel 6 Concrete tile 9 ABS 11 Other (specify)
12 None used (open hole)
SCREEN OR PERFORATION OPENINGS ARE:
1 Continuous slot 3 Mill slot 5 Gauzed wrapped 8 Saw cut 11 None (open hole)
2 Louvered shutter 4 Key punched 6 Wire wrapped 9 Drilled holes
7 Torch cut 10 Other (specify) ft.
SCREEN-PERFORATED INTERVALS: From 6.7 ft. to 69.5 ft., From ft. to ft.
GRAVEL PACK INTERVALS: From 6.5 ft. to 7.0 ft., From ft. to ft.

6 GROUT MATERIAL: 1 Neat cement 2 Cement grout 3 Bentonite 4 Other
Grout Intervals: From 1 ft. to 6.2 ft., From 6.2 ft. to 6.5 ft., From ft. to ft.
What is the nearest source of possible contamination:
1 Septic tank 4 Lateral lines 7 Pit privy 10 Livestock pens 14 Abandoned water well
2 Sewer lines 5 Cess pool 8 Sewage lagoon 11 Fuel storage 15 Oil well/Gas well
3 Watertight sewer lines 6 Seepage pit 9 Feedyard 12 Fertilizer storage 13 Insecticide storage
16 Other (specify below) LUST SITE
Direction from well? How many feet?

FROM	TO	LITHOLOGIC LOG	FROM	TO	PLUGGING INTERVALS
0'	1'	Topsoil	57'	62'	Sand, slightly silty, fine to coarse, odor
1'	7'	Clay, brown, silty, mod. plasticity, dry, dense	62'	70'	Clay, reddish brown, sandy fine to coarse grains
7'	27'	Clay, reddish brown, v. silty, <15% silty, mod. plasticity, dry			
27'	35'	Clay, brown, silty, dense med plasticity, dry, calcite layering			
35'	37'	CaCO3, white clayey			
37'	54'	Clay, light brown, silty, dense, moderate plasticity moist			
54'	57'	Clay, sandy, fine to medium			

7 CONTRACTOR'S OR LANDOWNER'S CERTIFICATION: This water well was (1) constructed, (2) reconstructed, or (3) plugged under my jurisdiction and was completed on (mo/day/year) 11/6/02 and this record is true to the best of my knowledge and belief. Kansas Water Well Contractor's Licence No. 594 This Water Well Record was completed on (mo/day/yr) 4/4/02 under the business name of Coranco Great Plains by (signature) Dennis Sprague