

ASW19

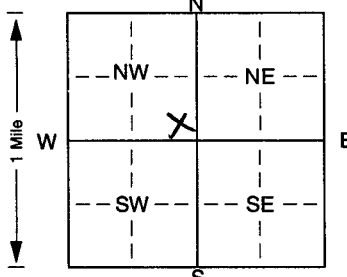
WATER WELL RECORD Form WWC-5 KSA 82a-1212 ID No.

1 LOCATION OF WATER WELL:	Fraction	Section Number	Township Number	Range Number
County: <u>Pratt</u>	<u>SE 1/4 SE 1/4 NW 1/4</u>	<u>03</u>	T <u>27</u> <u>S</u>	R <u>13</u> <u>EW</u>

Distance and direction from nearest town or city street address of well if located within city?

Main & Sumner Iuka Kansas 67066

2 WATER WELL OWNER: <u>Iuka Coop</u>	Board of Agriculture, Division of Water Resources
RR#, St. Address, Box # : <u>P.O. Box 175</u>	Application Number:
City, State, ZIP Code : <u>Iuka Kansas 67066</u>	

3 LOCATE WELL'S LOCATION WITH AN "X" IN SECTION BOX:	4 DEPTH OF COMPLETED WELL: <u>70</u> ft. ELEVATION: <u>1943.39</u>
	Depth(s) Groundwater Encountered 1. <u>48</u> ft. 2. ft. 3. ft.
	WELL'S STATIC WATER LEVEL: <u>40</u> ft. below land surface measured on mo/day/yr <u>11/21/02</u>
	Pump test data: Well water was ft. after hours pumping gpm
	Est. Yield gpm: Well water was ft. after hours pumping gpm
	Bore Hole Diameter: <u>8.25</u> in. to <u>70</u> ft., and in. to ft.
	WELL WATER TO BE USED AS: 5 Public water supply 8 Air conditioning 11 Injection well
	1 Domestic 3 Feedlot 6 Oil field water supply 9 Dewatering 12 Other (Specify below)
	2 Irrigation 4 Industrial 7 Domestic (lawn & garden) <u>10</u> Monitoring well
	Was a chemical/bacteriological sample submitted to Department? Yes. <u>(No)</u> ; If yes, mo/day/yr sample was submitted
	Water Well Disinfected? Yes <u>(No)</u>

5 TYPE OF BLANK CASING USED:	5 Wrought iron	8 Concrete tile	CASING JOINTS: Glued. Clamped.
1 Steel	3 RMP (SR)	6 Asbestos-Cement	9 Other (specify below)
<u>2</u> PVC	4 ABS	7 Fiberglass	10 Asbestos-cement
Blank casing diameter <u>10.206</u> in. to <u>67</u> ft., Dia.			11 Other (specify)
Casing height above land surface <u>35.75</u> in., weight <u>0.8</u> lbs./ft.			12 None used (open hole)
TYPE OF SCREEN OR PERFORATION MATERIAL:			
1 Steel	3 Stainless steel	5 Fiberglass	8 RMP (SR)
2 Brass	4 Galvanized steel	6 Concrete tile	9 ABS
SCREEN OR PERFORATION OPENINGS ARE:			
1 Continuous slot	<u>3</u> Mill slot	5 Gauzed wrapped	8 Saw cut
2 Louvered shutter	4 Key punched	6 Wire wrapped	9 Drilled holes
SCREEN-PERFORATED INTERVALS: From <u>67.0</u> ft. to <u>69.5</u> ft.			10 Other (specify) ft.
GRAVEL PACK INTERVALS: From <u>65</u> ft. to <u>70</u> ft.			

6 GROUT MATERIAL:	1 Neat cement	2 Cement grout	<u>3</u> Bentonite	4 Other
Grout Intervals: From <u>1</u> ft. to <u>62</u> ft., From <u>62</u> ft. to <u>65</u> ft.				
What is the nearest source of possible contamination:				
1 Septic tank	4 Lateral lines	7 Pit privy	10 Livestock pens	14 Abandoned water well
2 Sewer lines	5 Cess pool	8 Sewage lagoon	11 Fuel storage	15 Oil well/Gas well
3 Watertight sewer lines	6 Seepage pit	9 Feedyard	12 Fertilizer storage	<u>16</u> Other (specify below)
			13 Insecticide storage	<u>LUSTSITE</u>
Direction from well?			How many feet?	

FROM	TO	LITHOLOGIC LOG	FROM	TO	PLUGGING INTERVALS
0'	1'	TOPSOIL			
1'	7'	Clay, brown, silty, dense mod. plasticity, dry, no odor.			
7'	28'	Clay, reddish brown, v. silty, dry, moderate plasticity, no odor.			
28'	37'	Clay, reddish brown, silty caliche layering, mod. plasticity			
37'	52'	dry clay, Lt. Brown, silty, moist High plasticity.			
52'	70'	Sand, clayey, fine to coarse grains 75%			

7 CONTRACTOR'S OR LANDOWNER'S CERTIFICATION: This water well was (1) constructed, (2) reconstructed, or (3) plugged under my jurisdiction and was completed on (mo/day/year) <u>11/21/02</u> and this record is true to the best of my knowledge and belief. Kansas Water Well Contractor's Licence No. <u>594</u> This Water Well Record was completed on (mo/day/yr) <u>4/14/02</u> under the business name of <u>Coranco Great Plains</u> by (signature) <u>Debra Laguerre</u>
