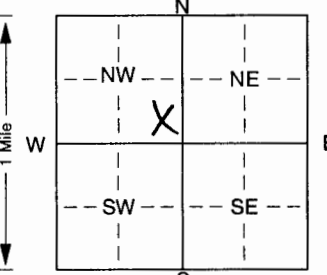


1 LOCATION OF WATER WELL: Fraction SE 1/4 SE 1/4 NW 1/4 Section Number 03 Township Number T 27 S Range Number R 13 E  
 County: Pratt  
 Distance and direction from nearest town or city street address of well if located within city?  
Main & Sumner Iuka Kansas 67066

2 WATER WELL OWNER: Iuka COOP  
 RR#, St. Address, Box #: P.O. Box 175 Board of Agriculture, Division of Water Resources  
 City, State, ZIP Code: Iuka Kansas 67066 Application Number: 1942-71

3 LOCATE WELL'S LOCATION WITH AN "X" IN SECTION BOX:  
  
 4 DEPTH OF COMPLETED WELL: 69.5 ft. ELEVATION: 1942.71  
 Depth(s) Groundwater Encountered: 1. ~48 ft. 2.          ft. 3.          ft.  
 WELL'S STATIC WATER LEVEL: 48 ft. below land surface measured on mo/day/yr 1/22/02  
 Pump test data: Well water was          ft. after          hours pumping          gpm  
 Est. Yield          gpm: Well water was          ft. after          hours pumping          gpm  
 Bore Hole Diameter: 8.25 in. to 7.0 in. and          in. to          in. ft.  
 WELL WATER TO BE USED AS:  
 1 Domestic 3 Feedlot 6 Oil field water supply 8 Air conditioning 11 Injection well  
 2 Irrigation 4 Industrial 7 Domestic (lawn & garden) 10 Monitoring well 12 Other (Specify below)  
 Was a chemical/bacteriological sample submitted to Department? Yes.       No  X; If yes, mo/day/yr sample was sub-  
 mitted Water Well Disinfected? Yes      No  X

5 TYPE OF BLANK CASING USED:  
 1 Steel 3 RMP (SR) 5 Wrought iron 8 Concrete tile CASING JOINTS: Glued      Clamped       
 PVC 4 ABS 7 Fiberglass      Welded       
     Threaded      PVC  
 Blank casing diameter: 10.2.06 in. to 67 ft., Dia          in. to          ft., Dia          in. to          ft.  
 Casing height above land surface: 35.88 in., weight 0.8 lbs./ft. Wall thickness or gauge No. SCH 40  
 TYPE OF SCREEN OR PERFORATION MATERIAL:  
 1 Steel 3 Stainless steel 5 Fiberglass 8 RMP (SR) 10 Asbestos-cement  
 2 Brass 4 Galvanized steel 6 Concrete tile 9 ABS 11 Other (specify)           
 12 None used (open hole)  
 SCREEN OR PERFORATION OPENINGS ARE:  
 1 Continuous slot      Mill slot 5 Gauzed wrapped 8 Saw cut 11 None (open hole)  
 2 Louvered shutter 4 Key punched 7 Torch cut 9 Drilled holes  
 10 Other (specify)          ft.  
 SCREEN-PERFORATED INTERVALS: From 67 ft. to 69.5 ft., From          ft. to          ft.  
 From          ft. to          ft., From          ft. to          ft.  
 GRAVEL PACK INTERVALS: From 65 ft. to 70 ft., From          ft. to          ft.  
 From          ft. to          ft., From          ft. to          ft.

6 GROUT MATERIAL: 1 Neat cement 2 Cement grout 3 Bentonite 4 Other           
 Grout intervals: From 1 ft. to 62 ft., From 62 ft. to 65 ft., From          ft. to          ft.  
 What is the nearest source of possible contamination:  
 1 Septic tank 4 Lateral lines 7 Pit privy 10 Livestock pens 14 Abandoned water well  
 2 Sewer lines 5 Cess pool 8 Sewage lagoon 11 Fuel storage 15 Oil well/Gas well  
 3 Watertight sewer lines 6 Seepage pit 9 Feedyard 12 Fertilizer storage      Other (specify below)  
         LUST SITE  
 13 Insecticide storage  
 Direction from well?          How many feet?         

FROM	TO	LITHOLOGIC LOG	FROM	TO	PLUGGING INTERVALS
0'	1'	Topsoil			
1'	7'	Clay, brown, silty, dense, moderate, plasticity, dry, no odor.			
7'	30'	Clay, reddish brown, v. silty dry, moderate plasticity.			
30'	35'	Clay, reddish brown, caliche layering, moderate plasticity			
35'	52'	Clay, light brown, silty, caliche layering, moderate plasticity, dry			
(@45) 52'	70'	Moist Sand, clayey, fine to coarse grain/SP			

7 CONTRACTOR'S OR LANDOWNER'S CERTIFICATION: This water well was (1) constructed, (2) reconstructed, or (3) plugged under my jurisdiction and was completed on (mo/day/year) 1/22/02 and this record is true to the best of my knowledge and belief. Kansas Water Well Contractor's Licence No. 594 This Water Well Record was completed on (mo/day/yr) 4/4/02 under the business name of Coranco Great Plains Inc. by (signature) Denise [Signature]