

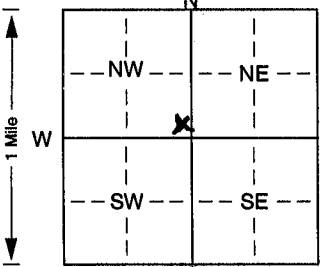
ASW26

WATER WELL RECORD Form WWC-5 KSA 82a-1212 ID No.

1 LOCATION OF WATER WELL:	Fraction	Section Number	Township Number	Range Number
County: <u>Pratt</u>	<u>SE 1/4 SE 1/4 NW 1/4</u>	<u>03</u>	T <u>27</u> S	R <u>13</u> <u>EW</u>

Distance and direction from nearest town or city street address of well if located within city?
Main & Sumner Iuka Kansas 67066

2 WATER WELL OWNER: <u>Iuka Coop</u>	Board of Agriculture, Division of Water Resources
RR#, St. Address, Box # : <u>Box 175</u>	Application Number:
City, State, ZIP Code : <u>Iuka Kansas 67066</u>	

3 LOCATE WELL'S LOCATION WITH AN "X" IN SECTION BOX:	4 DEPTH OF COMPLETED WELL: <u>69</u> ft. ELEVATION: <u>1942.89</u>
	Depth(s) Groundwater Encountered <u>1.48</u> ft. 2. ft. 3. ft.
	WELL'S STATIC WATER LEVEL <u>46.58</u> ft. below land surface measured on mo/day/yr <u>1-22-02</u>
	Pump test data: Well water was ft. after hours pumping gpm
	Est. Yield gpm: Well water was ft. after hours pumping gpm
	Bore Hole Diameter <u>8.25</u> in. to <u>70</u> ft. and in. to ft.
	WELL WATER TO BE USED AS: 5 Public water supply 8 Air conditioning 11 Injection well
	1 Domestic 3 Feedlot 6 Oil field water supply 9 Dewatering 12 Other (Specify below)
	2 Irrigation 4 Industrial 7 Domestic (lawn & garden) 10 Monitoring well
	Was a chemical/bacteriological sample submitted to Department? Yes <u>No</u> X; If yes, mo/day/yr sample was submitted
	Water Well Disinfected? Yes <u>No</u> X

5 TYPE OF CASING USED:	5 Wrought iron	8 Concrete tile	CASING JOINTS: Glued. Clamped.
1 Steel	6 Asbestos-Cement	9 Other (specify below)	Welded
2 PVC	7 Fiberglass		Threaded <u>PVC</u>
Blank casing diameter <u>10/2.06</u> in. to <u>66.5</u> ft., Dia			
Casing height above land surface <u>40.2</u> in., weight <u>0.8</u> lbs./ft. Wall thickness or gauge No. <u>SCH 40</u>			
TYPE OF SCREEN OR PERFORATION MATERIAL:	7 PVC	10 Asbestos-cement	
1 Steel	8 RMP (SR)	11 Other (specify)	
2 Brass	9 ABS	12 None used (open hole)	
3 Stainless steel			
4 Galvanized steel			
6 Concrete tile			
SCREEN OR PERFORATION OPENINGS ARE:	5 Gauzed wrapped	8 Saw cut	11 None (open hole)
1 Continuous slot	6 Wire wrapped	9 Drilled holes	
2 Louvered shutter	7 Torch cut	10 Other (specify)	
3 Mill slot			
4 Key punched			
SCREEN-PERFORATED INTERVALS: From <u>66.5</u> ft. to <u>69</u> ft., From ft. to ft.			
GRAVEL PACK INTERVALS: From <u>64.5</u> ft. to <u>70</u> ft., From ft. to ft.			

6 GROUT MATERIAL:	1 Neat cement	2 Cement grout	3 Bentonite	4 Other
Grout Intervals: From <u>1</u> ft. to <u>67.5</u> ft., From <u>67.5</u> ft. to <u>69</u> ft., From ft. to ft.				
What is the nearest source of possible contamination:	10 Livestock pens	14 Abandoned water well		
1 Septic tank	11 Fuel storage	15 Oil well/Gas well		
2 Sewer lines	12 Fertilizer storage	16 Other (specify below)		
3 Watertight sewer lines	13 Insecticide storage	<u>LUST SITE</u>		
4 Lateral lines				
5 Cess pool				
6 Seepage pit				
7 Pit privy				
8 Sewage lagoon				
9 Feedyard				
Direction from well?	How many feet?			

FROM	TO	LITHOLOGIC LOG	FROM	TO	PLUGGING INTERVALS
0'	1'	TOPSOIL			
1'	7'	clay, brown, Silty			
		Moderate Plasticity, dry			
7'	29'	Clay, reddish, brown v.			
		silty, dry, mod. Plasticity			
29'	31'	Clay, Fine Sandy, Lt. Brown			
		Caliche, layering, dry			
31'	40'	Clay, Light Brown, Silty			
		moderate plasticity, dry			
40'	52'	Clay, Fine, Sandy, brown			
		moderate plasticity			
52'	70'	Sand, clayey, fine, to			
		coarse, grain			

7 CONTRACTOR'S OR LANDOWNER'S CERTIFICATION: This water well was (1) constructed, (2) reconstructed, or (3) plugged under my jurisdiction and was completed on (mo/day/year) <u>4/4/02</u> and this record is true to the best of my knowledge and belief. Kansas Water Well Contractor's Licence No. <u>594</u> This Water Well Record was completed on (mo/day/yr) under the business name of <u>Coranco Great Plains</u> by (signature) <u>Donna Laguerre</u>
--