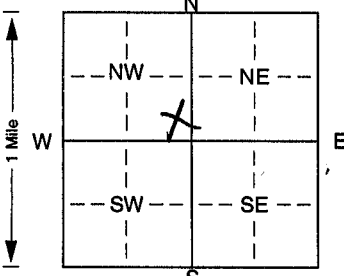


1 LOCATION OF WATER WELL: Fraction SE 1/4 SE 1/4 NW 1/4 Section Number 03 Township Number T 27 S Range Number R 13 EW  
 County: Pratt

Distance and direction from nearest town or city street address of well if located within city?  
MAIN & Sumner Iuka Kansas 67066

2 WATER WELL OWNER: Iuka Coop  
 RR#, St. Address, Box #: Box 175  
 City, State, ZIP Code: Iuka Kansas 67066-191  
 Board of Agriculture, Division of Water Resources  
 Application Number:

3 LOCATE WELL'S LOCATION WITH AN "X" IN SECTION BOX:  
  
 4 DEPTH OF COMPLETED WELL: 49 ft. ELEVATION: 1943.57  
 Depth(s) Groundwater Encountered 1 ft. 48 ft. 2. .... ft. 3. .... ft.  
 WELL'S STATIC WATER LEVEL 46.70 ft. below land surface measured on mo/day/yr 1/23/02  
 Pump test data: Well water was .... ft. after .... hours pumping .... gpm  
 Est. Yield .... gpm: Well water was .... ft. after .... hours pumping .... gpm  
 Bore Hole Diameter: 8.25 in. to 50 in. to .... in. to .... in. to .... ft.  
 WELL WATER TO BE USED AS: 5 Public water supply 8 Air conditioning 11 Injection well  
 1 Domestic 3 Feedlot 6 Oil field water supply 9 Dewatering 12 Other (Specify below)  
 2 Irrigation 4 Industrial 7 Domestic (lawn & garden) 10 Monitoring well  
 Was a chemical/bacteriological sample submitted to Department? Yes NO X; If yes, mo/day/yr sample was submitted  
 Water Well Disinfected? Yes NO X

5 TYPE OF BLANK CASING USED:  
 1 Steel 3 RMP (SR) 6 Asbestos-Cement 9 Other (specify below) Welded  
2 PVC 4 ABS 7 Fiberglass Threaded PVC  
 Blank casing diameter 3.375 in. to 34 in. Dia. .... in. to .... in. to .... ft. Dia. .... in. to .... ft.  
 Casing height above land surface: 36.48 in., weight 0.8 lbs./ft. Wall thickness or gauge No. SCH 40  
 TYPE OF SCREEN OR PERFORATION MATERIAL: GPVC  
 1 Steel 3 Stainless steel 5 Fiberglass 8 RMP (SR) 10 Asbestos-cement  
 2 Brass 4 Galvanized steel 6 Concrete tile 9 ABS 11 Other (specify) ....  
 12 None used (open hole)  
 SCREEN OR PERFORATION OPENINGS ARE:  
 1 Continuous slot 3 Mill slot 5 Gauzed wrapped 8 Saw cut 11 None (open hole)  
 2 Louvered shutter 4 Key punched 6 Wire wrapped 9 Drilled holes  
 7 Torch cut 10 Other (specify) .... ft.  
 SCREEN-PERFORATED INTERVALS: From 34 ft. to 49 ft., From .... ft. to .... ft.  
 From .... ft. to .... ft., From .... ft. to .... ft.  
 GRAVEL PACK INTERVALS: From 32 ft. to 50 ft., From .... ft. to .... ft.  
 From .... ft. to .... ft., From .... ft. to .... ft.

6 GROUT MATERIAL: 1 Neat cement 2 Cement grout 3 Bentonite 4 Other  
 Grout Intervals: From 1 ft. to 29 ft. From 29 ft. to 32 ft. From .... ft. to .... ft.  
 What is the nearest source of possible contamination:  
 1 Septic tank 4 Lateral lines 7 Pit privy 10 Livestock pens 14 Abandoned water well  
 2 Sewer lines 5 Cess pool 8 Sewage lagoon 11 Fuel storage 15 Oil well/Gas well  
 3 Watertight sewer lines 6 Seepage pit 9 Feedyard 12 Fertilizer storage 18 Other (specify below)  
13 Insecticide storage LUST SITE  
 Direction from well? How many feet?

FROM	TO	LITHOLOGIC LOG	FROM	TO	PLUGGING INTERVALS
0'	1'	TOPSOIL			
1'	7'	Clay, brown, silty, dense, moderate plasticity, dry. NO odor			
7'	28'	Clay, reddish brown, v. silty >15% dry, moderate plasticity			
28'	36'	Fine sand, brown clayey, well-sorted, dry.			
36'	40'	Clay, brown, silty, mod. plasticity, dry, no odor			
40'	44'	Fine sand, light brown, well sorted, dry.			
44'	50'	Clay, brown, silty, dense, high plasticity, moist.			

7 CONTRACTOR'S OR LANDOWNER'S CERTIFICATION: This water well was (1) constructed, (2) reconstructed, or (3) plugged under my jurisdiction and was completed on (mo/day/year) 1/23/02 and this record is true to the best of my knowledge and belief. Kansas Water Well Contractor's Licence No. 594 This Water Well Record was completed on (mo/day/yr) 4/4/02 under the business name of Coranco Great Plains Inc. by (signature) Denise Spurgeon