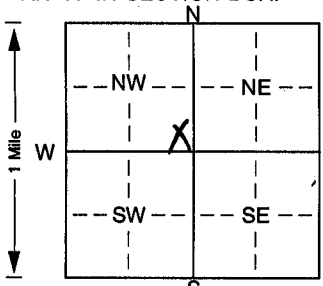


1 LOCATION OF WATER WELL: Fraction SE 1/4 SE 1/4 NW 1/4 Section Number 03 Township Number T 27 S Range Number R 13 E/W
 County: Pratt

Distance and direction from nearest town or city street address of well if located within city?
Maine Summer 1/4 mi Kansas 67066

2 WATER WELL OWNER: Iuka Coop
 RR#, St. Address, Box #: Box 175
 City, State, ZIP Code: Iuka Kansas 67066
 Board of Agriculture, Division of Water Resources
 Application Number: 49.5

3 LOCATE WELL'S LOCATION WITH AN "X" IN SECTION BOX:

 4 DEPTH OF COMPLETED WELL: 49.5 ft. ELEVATION: 1943.07
 Depth(s) Groundwater Encountered: 1 ft. 2. ft. 3. ft.
 WELL'S STATIC WATER LEVEL: ~48 ft. below land surface measured on mo/day/yr 1/23/02
 Pump test data: Well water was ft. after hours pumping gpm
 Est. Yield gpm: Well water was ft. after hours pumping gpm
 Bore Hole Diameter: 10.25 in. to 50' ft., and in. to ft.
 WELL WATER TO BE USED AS: 5 Public water supply 8 Air conditioning 11 Injection well
 1 Domestic 3 Feedlot 6 Oil field water supply 9 Dewatering 12 Other (Specify below)
 2 Irrigation 4 Industrial 7 Domestic (lawn & garden) 10 Monitoring well
 Was a chemical/bacteriological sample submitted to Department? Yes. No X; If yes, mo/day/yrs sample was submitted
 Water Well Disinfected? Yes No X

5 TYPE OF BLANK CASING USED:
 1 Steel 3 RMP (SR) 5 Wrought iron 8 Concrete tile CASING JOINTS: Glued. Clamped.
 2 PVC 4 ABS 7 Fiberglass Welded Threaded PVC
 Blank casing diameter 10.402 in. to 34.5 ft., Dia in. to ft., Dia in. to ft.
 Casing height above land surface: 34.84 in., weight 0.8 lbs./ft. Wall thickness or gauge No. sch 40
 TYPE OF SCREEN OR PERFORATION MATERIAL: PVC
 1 Steel 3 Stainless steel 5 Fiberglass 8 RMP (SR) 10 Asbestos-cement
 2 Brass 4 Galvanized steel 6 Concrete tile 9 ABS 11 Other (specify)
 12 None used (open hole)
 SCREEN OR PERFORATION OPENINGS ARE:
 1 Continuous slot 3 Mill slot 5 Gauzed wrapped 8 Saw cut 11 None (open hole)
 2 Louvered shutter 4 Key punched 6 Wire wrapped 9 Drilled holes
 7 Torch cut 10 Other (specify) ft.
 SCREEN-PERFORATED INTERVALS: From 34.5 ft. to 49 ft., From ft. to ft.
 From ft. to ft., From ft. to ft.
 GRAVEL PACK INTERVALS: From 32.5 ft. to 50 ft., From ft. to ft.
 From ft. to ft., From ft. to ft.

6 GROUT MATERIAL: 1 Neat cement 2 Cement grout 3 Bentonite 4 Other
 Grout Intervals: From 1 ft. to 29.5 ft., From 29.5 ft. to 32.5 ft., From ft. to ft.
 What is the nearest source of possible contamination:
 1 Septic tank 4 Lateral lines 7 Pit privy 10 Livestock pens 14 Abandoned water well
 2 Sewer lines 5 Cess pool 8 Sewage lagoon 11 Fuel storage 15 Oil well/Gas well
 3 Watertight sewer lines 6 Seepage pit 9 Feedyard 12 Fertilizer storage 16 Other (specify below)
LUCKY SITE
 13 Insecticide storage
 Direction from well? How many feet?

FROM	TO	LITHOLOGIC LOG	FROM	TO	PLUGGING INTERVALS
0'	1'	TOP SOIL			
1'	8'	Clay, brown, silty, dense moderate plasticity, dry no odor			
8'	27'	Clay, reddish brown, v. silty, dry, mod. plasticity no odor.			
27'	31'	Fine sandy, clay, light brown, caliche layering, dry.			
31'	40'	Clay, light brown, silty, mod plasticity, dense, dry			
40'	50'	Clay, fine sandy, brown mod plasticity, moist			

7 CONTRACTOR'S OR LANDOWNER'S CERTIFICATION: This water well was (1) constructed, (2) reconstructed, or (3) plugged under my jurisdiction and was completed on (mo/day/year) 1/23/02 and this record is true to the best of my knowledge and belief. Kansas Water Well Contractor's Licence No. 594 This Water Well Record was completed on (mo/day/yr) 4/3/02 under the business name of Coranco Great Plains by (signature) [Signature]