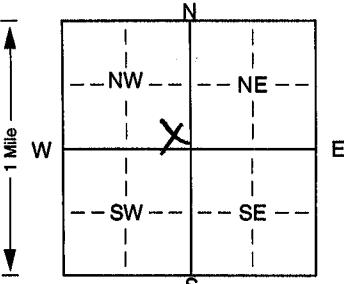


1 LOCATION OF WATER WELL:	Fraction	Section Number	Township Number	Range Number
County: <u>Pratt</u>	<u>SE 1/4 SE 1/4 NW 1/4</u>	<u>03</u>	<u>T 27 S</u>	<u>R 13 E</u>

Distance and direction from nearest town or city street address of well if located within city?

MAIN & Sumner Iuka Kansas 67066

2 WATER WELL OWNER:	Board of Agriculture, Division of Water Resources
RR#, St. Address, Box # :	Application Number:
City, State, ZIP Code :	<u>1944-73</u>

3 LOCATE WELL'S LOCATION WITH AN "X" IN SECTION BOX:	4 DEPTH OF COMPLETED WELL: <u>50</u> ft. ELEVATION: <u>1944.73</u>
	Depth(s) Groundwater Encountered <u>48</u> ft. 2. <u>48</u> ft. 3. <u>11/22/02</u> ft.
	WELL'S STATIC WATER LEVEL <u>48</u> ft. below land surface measured on mo/day/yr
	WELL WATER TO BE USED AS: 5 Public water supply 8 Air conditioning 11 Injection well
	1 Domestic 3 Feedlot 6 Oil field water supply 9 Dewatering 12 Other (Specify below)
	2 Irrigation 4 Industrial 7 Domestic (lawn & garden) 10 Monitoring well
	Was a chemical/bacteriological sample submitted to Department? Yes. <u>No.</u> If yes, mo/day/yr sample was submitted
	Water Well Disinfected? Yes <u>No</u>

5 TYPE OF BLANK CASING USED:	5 Wrought iron	8 Concrete tile	CASING JOINTS: Glued. <u>Clamped.</u>
1 Steel	3 RMP (SR)	6 Asbestos-Cement	9 Other (specify below)
<u>PVC</u>	<u>4 ABS</u>	<u>7 Fiberglass</u>	<u>Welded</u>
Blank casing diameter <u>4.02</u> in. to <u>35</u> ft., Dia			<u>Threaded</u>
Casing height above land surface <u>36.72</u> in., weight			<u>PVC</u>
TYPE OF SCREEN OR PERFORATION MATERIAL:	<u>PVC</u>	10 Asbestos-cement	
1 Steel	3 Stainless steel	5 Fiberglass	8 RMP (SR)
2 Brass	4 Galvanized steel	6 Concrete tile	9 ABS
SCREEN OR PERFORATION OPENINGS ARE:	5 Gauzed wrapped	8 Saw cut	11 None (open hole)
1 Continuous slot	6 Wire wrapped	9 Drilled holes	
2 Louvered shutter	7 Torch cut	10 Other (specify)	
SCREEN-PERFORATED INTERVALS: From <u>35</u> ft. to <u>50</u> ft., From			
GRAVEL PACK INTERVALS: From <u>33</u> ft. to <u>50</u> ft., From			

6 GROUT MATERIAL:	1 Neat cement	2 Cement grout	3 Bentonite	4 Other
Grout Intervals: From <u>1</u> ft. to <u>30</u> ft., From <u>30</u> ft. to <u>33</u> ft., From				
What is the nearest source of possible contamination:	10 Livestock pens	14 Abandoned water well		
1 Septic tank	4 Lateral lines	7 Pit privy	11 Fuel storage	15 Oil well/Gas well
2 Sewer lines	5 Cess pool	8 Sewage lagoon	12 Fertilizer storage	16 Other (specify below)
3 Watertight sewer lines	6 Seepage pit	9 Feedyard	13 Insecticide storage	<u>LIST SITE</u>
Direction from well?			How many feet?	

FROM	TO	LITHOLOGIC LOG	FROM	TO	PLUGGING INTERVALS
<u>0'</u>	<u>1'</u>	<u>Topsoil</u>			
<u>1'</u>	<u>7'</u>	<u>Clay, Brown, Silty, dry,</u>			
		<u>mod. plasticity</u>			
<u>7'</u>	<u>27'</u>	<u>Clay, reddish brown, 2/3 B/O</u>			
		<u>silty, dense, dry, mod.</u>			
		<u>plasticity, No odor.</u>			
<u>27'</u>	<u>35'</u>	<u>Clay, brown, silty, dense</u>			
		<u>mod. plasticity, dry, caliche</u>			
		<u>layering, No odor</u>			
<u>37'</u>	<u>50'</u>	<u>Clay, lt. brown, silty, dense</u>			
		<u>mod plasticity, moist.</u>			

7 CONTRACTOR'S OR LANDOWNER'S CERTIFICATION: This water well was (1) constructed, (2) reconstructed, or (3) plugged under my jurisdiction and was completed on (mo/day/year) <u>1/22/02</u> and this record is true to the best of my knowledge and belief. Kansas Water Well Contractor's Licence No. <u>294</u> This Water Well Record was completed on (mo/day/yr) <u>7/7/02</u> under the business name of <u>Coranco Great Plains</u> by (signature) <u>[Signature]</u>
--