


1 LOCATION OF WATER WELL: Fraction Section Number Township Number Range Number
 County: Pratt NE 1/4 NE 1/4 NW 1/4 34 27-S 13-W

Distance and direction from nearest town or city street address of well if located within city?
516 E 1st St Pratt KS A1-7

2 WATER WELL OWNER: Tucker Oil & Gas
P.O. Box 63
 RR #, St. Address, Box #: KINGMAN, KS 67048
 City, State, ZIP Code : KINGMAN, KS 67048
 Board of Agriculture, Division of Water Resources
 Application Number:

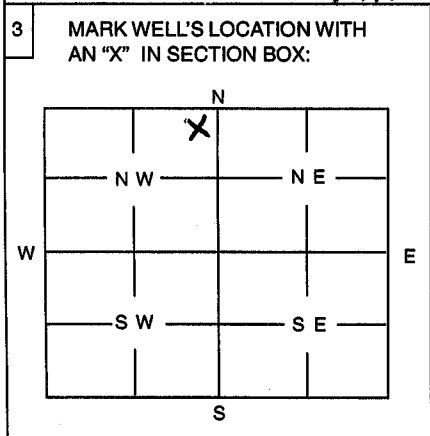

4 DEPTH OF WELL 57 ft
 WELL'S STATIC WATER LEVEL ft.
 WELL WAS USED AS:
 1 Domestic 5 Public Water Supply 9 Dewatering
 2 Irrigation 6 Oil Field Water Supply 10 Monitoring Well
 3 Feedlot 7 Domestic (Lawn & Garden) 11 Injection Well
 4 Industrial 8 Air Conditioning 12 Other S.P.A.C.E.
 Was a chemical / bacteriological sample submitted to Department? Yes No -
 If yes, mo/day/yr sample was submitted
 Water Well Disinfected: Yes No -

5 TYPE OF BLANK CASING USED:
 1 Steel 3 RMP (SR) 5 Wrought 7 Fiberglass 9 Other (Specify below)
 2 PVC 4 ABS 6 Asbestos-Cement 8 Concrete Tile
 Blank casing diameter 1 in. Was casing pulled? Yes No If yes, how much 3'
 Casing height above or below land surface in.

6 GROUT PLUG MATERIAL: 1 Neat cement 2 Cement grout 3 Bentonite 4 Other 5000 PSI CONCRETE
 Grout Plug Intervals: From ft. to ft., From 57 ft. to 1 ft., From 1 to 0 ft.
 What is the nearest source of possible contamination:
 1 Septic tank 6 Seepage pit 11 Fuel storage 12 Other (specify below) OST FORMER
 2 Sewer lines 7 Pit privy 12 Fertilizer storage
 3 Watertight sewer lines 8 Sewage lagoon 13 Insecticide storage
 4 Lateral lines 9 Feedyard 14 Abandoned water well
 5 Cess Pool 10 Livestock pens 15 Oil well/Gas well
 Direction from well? Northwest How many feet? 525

FROM	TO	PLUGGING MATERIALS
<u>57</u>	<u>1</u>	<u>BENTONITE 1/4"</u>
<u>1</u>	<u>0</u>	<u>CONCRETE</u>

7 CONTRACTOR'S OR LANDOWNER'S CERTIFICATION: This water well was plugged under my jurisdiction and was completed on (mo/day/year) 4-30-02 and this record is true to the best of my knowledge and belief. Kansas Water Well Contractor's License No. 575 This Water Well Record was completed on (mo/day/year) 5-3-02 under the business name of FUNKIE Drilling SERVICE, Inc. by (signature) [Signature]

INSTRUCTIONS: Use typewriter or ball point pen. Please press firmly and print clearly. Please fill in blanks, underline or circle the correct answers. Send top three copies to Kansas Department of Health and Environment, Bureau of Water, Topeka, Kansas 66620-0001. Telephone: 785/296-3565. Send one to Water Well Owner and retain one for your records.