


TAGA 265449

1	LOCATION OF WATER WELL:	Fraction	Section Number	Township Number	Range Number
County:	<i>Pratt</i>	<i>NE 1/4 NE 1/4 NW 1/4</i>	<i>34</i>	<i>27-5</i>	<i>13-W</i>

Distance and direction from nearest town or city street address of well if located within city?
516 E 1st St Pratt, KS *VIEW-5*

2 WATER WELL OWNER: *TUCKER OIL LOGS*
 RR #, St. Address, Box #: *P.O. Box 63*
 City, State, ZIP Code: *Pratt, KS 67068*
 Board of Agriculture, Division of Water Resources
 Application Number: _____

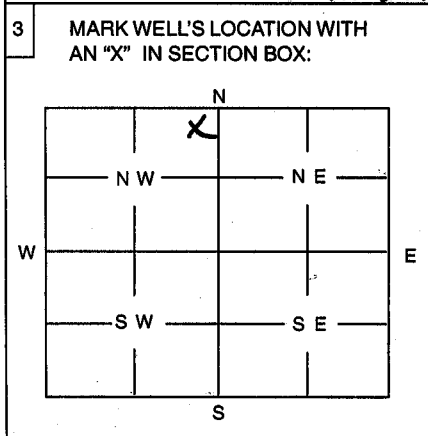

4 DEPTH OF WELL *45* ft
 WELL'S STATIC WATER LEVEL ft.
 WELL WAS USED AS:
 1 Domestic 5 Public Water Supply 9 Dewatering
 2 Irrigation 6 Oil Field Water Supply 10 Monitoring Well
 3 Feedlot 7 Domestic (Lawn & Garden) 11 Injection Well
 4 Industrial 8 Air Conditioning 12 Other *Vapor Extractive*

Was a chemical / bacteriological sample submitted to Department? Yes No —
 If yes, mo/day/yr sample was submitted

Water Well Disinfected: Yes No —

5 TYPE OF BLANK CASING USED:
 1 Steel 3 RMP (SR) 5 Wrought 7 Fiberglass 9 Other (Specify below)
 2 PVC 4 ABS 6 Asbestos-Cement 8 Concrete Tile

Blank casing diameter *4* in. Was casing pulled? Yes No If yes, how much *3'*

Casing height above or below land surface *0.3* in.

6 GROUT PLUG MATERIAL: 1 Neat cement 2 Cement grout 3 Bentonite 4 Other *5000 P.I.T. Concrete*
 Grout Plug Intervals: From *4.5* ft. to *1* ft., From ft. to ft., From *1* to *0* ft.

What is the nearest source of possible contamination:
 1 Septic tank 6 Seepage pit 11 Fuel storage 12 Fertilizer storage 13 Insecticide storage
 2 Sewer lines 7 Pit privy 14 Abandoned water well
 3 Watertight sewer lines 8 Sewage lagoon 15 Oil well/Gas well
 4 Lateral lines 9 Feedyard
 5 Cess Pool 10 Livestock pens

Direction from well? *North* How many feet? *210*

Other (specify below) *V.S.T. FORMER*

FROM	TO	PLUGGING MATERIALS
<i>4.5</i>	<i>1</i>	<i>CEMENT GROUT w 6% Bentonite</i>
<i>1</i>	<i>0</i>	<i>CONCRETE</i>

7 CONTRACTOR'S OR LANDOWNER'S CERTIFICATION: This water well was plugged under my jurisdiction and was completed on (mo/day/year) *4-30-02* and this record is true to the best of my knowledge and belief. Kansas Water Well Contractor's License No. *575* This Water Well Record was completed on (mo/day/year) *5-3-02* under the business name of *FUNKER DRILLING SERVICE* by (signature) *[Signature]*

INSTRUCTIONS: Use typewriter or ball point pen. Please press firmly and print clearly. Please fill in blanks, underline or circle the correct answers. Send top three copies to Kansas Department of Health and Environment, Bureau of Water, Topeka, Kansas 66620-0001. Telephone: 785/296-3565. Send one to Water Well Owner and retain one for your records.