


1 LOCATION OF WATER WELL: Fraction Section Number Township Number Range Number
 County: Pratt NE^{1/4} NE^{1/4} NW^{1/4} 34 27-S 13-W

Distance and direction from nearest town or city street address of well if located within city?
516 E 1st St Pratt, KS VIEW # 6

2 WATER WELL OWNER: Tucker Oil & Gas
 RR #, St. Address, Box #: P.O. Box 63
 City, State, ZIP Code : KINEMAN, KS 67068
 Board of Agriculture, Division of Water Resources
 Application Number:

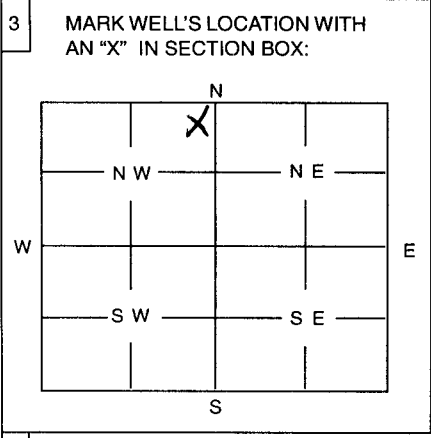

4 DEPTH OF WELL 45 ft
 WELL'S STATIC WATER LEVEL ft.
 WELL WAS USED AS:
 1 Domestic 5 Public Water Supply 9 Dewatering
 2 Irrigation 6 Oil Field Water Supply 10 Monitoring Well
 3 Feedlot 7 Domestic (Lawn & Garden) 11 Injection Well
 4 Industrial 8 Air Conditioning 12 Other Vapor Extractor

Was a chemical / bacteriological sample submitted to Department? Yes No
 If yes, mo/day/yr sample was submitted

Water Well Disinfected: Yes No

5 TYPE OF BLANK CASING USED:
 1 Steel 3 RMP (SR) 5 Wrought 7 Fiberglass 9 Other (Specify below)
 PVC 4 ABS 6 Asbestos-Cement 8 Concrete Tile

Blank casing diameter 4 in. Was casing pulled? Yes No If yes, how much 31

Casing height above or below land surface 13 in.

6 GROUT PLUG MATERIAL: 1 Neat cement Cement grout 3 Bentonite 4 Other 5.000 P.H. Concrete

Grout Plug Intervals: From 45 ft. to 1 ft., From ft. to 1 ft., From 1 to 0 ft.

What is the nearest source of possible contamination:
 1 Septic tank 6 Seepage pit 11 Fuel storage 16 Other (specify below)
 2 Sewer lines 7 Pit privy 12 Fertilizer storage FORMER UST
 3 Watertight sewer lines 8 Sewage lagoon 13 Insecticide storage
 4 Lateral lines 9 Feedyard 14 Abandoned water well
 5 Cess Pool 10 Livestock pens 15 Oil well/Gas well

Direction from well? North west How many feet? 330

FROM	TO	PLUGGING MATERIALS
<u>45</u>	<u>1</u>	<u>CEMENT GROUT w 6% Bentonite</u>
<u>1</u>	<u>0</u>	<u>CONCRETE</u>

7 CONTRACTOR'S OR LANDOWNER'S CERTIFICATION: This water well was plugged under my jurisdiction and was completed on (mo/day/year) 4-30-02 and this record is true to the best of my knowledge and belief. Kansas Water Well Contractor's License No. 575 This Water Well Record was completed on (mo/day/year) 5-3-02 under the business name of FUNKER DRILLING SERVICE INC by (signature) [Signature]

INSTRUCTIONS: Use typewriter or ball point pen. Please press firmly and print clearly. Please fill in blanks, underline or circle the correct answers. Send top three copies to Kansas Department of Health and Environment, Bureau of Water, Topeka, Kansas 66620-0001. Telephone: 785/296-3565. Send one to Water Well Owner and retain one for your records.