


1 LOCATION OF WATER WELL: County: <u>Pratt</u>	Fraction <u>NE 1/4 NE 1/4 NW 1/4</u>	Section Number <u>34</u>	Township Number <u>27-S</u>	Range Number <u>13-W</u>
---	--------------------------------------	--------------------------	-----------------------------	--------------------------

Distance and direction from nearest town or city street address of well if located within city?
516 E 1st St Pratt, Ks VIEW #7

2 WATER WELL OWNER: <u>TUCKER OIL & GAS</u> RR #, St. Address, Box #: <u>P.O. Box 63</u> City, State, ZIP Code: <u>KINGMAN, KS 67068</u>	Board of Agriculture, Division of Water Resources Application Number: _____
--	--

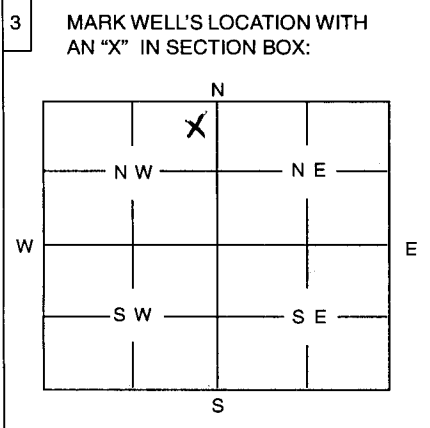

4 DEPTH OF WELL 45 ft.
 WELL'S STATIC WATER LEVEL _____ ft.
 WELL WAS USED AS:

1 Domestic	5 Public Water Supply	9 Dewatering
2 Irrigation	6 Oil Field Water Supply	10 Monitoring Well
3 Feedlot	7 Domestic (Lawn & Garden)	11 Injection Well
4 Industrial	8 Air Conditioning	<input checked="" type="checkbox"/> Other <u>V.M.P.O. Extractor</u>

Was a chemical / bacteriological sample submitted to Department? Yes _____ No _____
 If yes, mo/day/yr sample was submitted _____
 Water Well Disinfected: Yes _____ No _____

5 TYPE OF BLANK CASING USED:

1 Steel	3 RMP (SR)	5 Wrought	7 Fiberglass	9 Other (Specify below)
<input checked="" type="checkbox"/> PVC	4 ABS	6 Asbestos-Cement	8 Concrete Tile	_____

Blank casing diameter 4 in. Was casing pulled? Yes _____ No _____ If yes, how much 3'
 Casing height above or below land surface 1.3 in.

6 GROUT PLUG MATERIAL: 1 Neat cement Cement grout 3 Bentonite 4 Other 5000 PSI Concrete

Grout Plug Intervals: From 45 ft. to 1 ft., From _____ ft. to _____ ft., From 1 to 0 ft.

What is the nearest source of possible contamination:

1 Septic tank	6 Seepage pit	11 Fuel storage	<input checked="" type="checkbox"/> Other (specify below)
2 Sewer lines	7 Pit privy	12 Fertilizer storage	<u>FARMER W.T.</u>
3 Watertight sewer lines	8 Sewage lagoon	13 Insecticide storage	
4 Lateral lines	9 Feedyard	14 Abandoned water well	
5 Cess Pool	10 Livestock pens	15 Oil well/Gas well	

Direction from well? Northwest How many feet? 570

FROM	TO	PLUGGING MATERIALS
<u>45</u>	<u>1</u>	<u>CEMENT GROUT W/6% BENTONITE</u>
<u>1</u>	<u>0</u>	<u>CONCRETE</u>

7 CONTRACTOR'S OR LANDOWNER'S CERTIFICATION: This water well was plugged under my jurisdiction and was completed on (mo/day/year) 4-30-02 and this record is true to the best of my knowledge and belief. Kansas Water Well Contractor's License No. 575 This Water Well Record was completed on (mo/day/year) 5-3-02 under the business name of TUCKER OIL & GAS SERVICE INC.
 by (signature) [Signature]

INSTRUCTIONS: Use typewriter or ball point pen. Please press firmly and print clearly. Please fill in blanks, underline or circle the correct answers. Send top three copies to Kansas Department of Health and Environment, Bureau of Water, Topeka, Kansas 66620-0001. Telephone: 785/296-3565. Send one to Water Well Owner and retain one for your records.