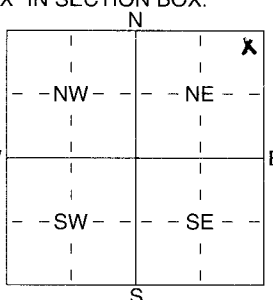


1 LOCATION OF WATER WELL: County: Pratt Fraction: NE 1/4 NE 1/4 NE 1/4 Section Number: 16 Township Number: T 27 S Range Number: R 13 E (W)

Distance and direction from nearest town or city street address of well if located within city?
at Pratt Airport - S side of Flint Rd approx 150' E of Barker Ave (MW12)

2 WATER WELL OWNER: Pratt Airport Authority (property owner)
 RR#, St. Address, Box #: PO Box 867 Board of Agriculture, Division of Water Resources
 City, State, ZIP Code: Pratt KS 67124 Application Number:

3 LOCATE WELL'S LOCATION WITH AN "X" IN SECTION BOX:

 4 DEPTH OF COMPLETED WELL: 63 ft. ELEVATION: not surveyed
 Depth(s) Groundwater Encountered: 1 ft. 2 ft. 3 ft.
 WELL'S STATIC WATER LEVEL: 61.66 ft. below land surface measured on mo/day/yr: Nov 5, 2002
 Pump test data: Well water was ft. after hours pumping gpm
 Est. Yield gpm: Well water was ft. after hours pumping gpm
 WELL WATER TO BE USED AS:
 5 Public water supply 8 Air conditioning 11 Injection well
 1 Domestic 3 Feedlot 6 Oil field water supply 9 Dewatering 12 Other (Specify below)
 2 Irrigation 4 Industrial 7 Domestic (lawn & garden) 10 Monitoring well
 Was a chemical/bacteriological sample submitted to Department? Yes No X; If yes, mo/day/yrs sample was submitted
 Water Well Disinfected? Yes No

5 TYPE OF BLANK CASING USED:
 1 Steel 3 RMP (SR) 5 Wrought iron 8 Concrete tile CASING JOINTS: Glued Clamped
 2 PVC 4 ABS 6 Asbestos-Cement 9 Other (specify below) Welded
 7 Fiberglass Threaded
 Blank casing diameter: 2 in. to 3.3 ft., Dia in. to ft., Dia in. to ft.
 Casing height above land surface: 24 in., weight lbs./ft. Wall thickness or gauge No. sch 40
 TYPE OF SCREEN OR PERFORATION MATERIAL:
 1 Steel 3 Stainless Steel 5 Fiberglass 7 PVC 10 Asbestos-Cement
 2 Brass 4 Galvanized Steel 6 Concrete tile 8 RMP (SR) 11 Other (Specify)
 9 ABS 12 None used (open hole)
 SCREEN OR PERFORATION OPENINGS ARE:
 1 Continuous slot 3 Mill slot 5 Gauzed wrapped 8 Saw cut 11 None (open hole)
 2 Louvered shutter 4 Key punched 6 Wire wrapped 9 Drilled holes
 7 Torch cut 10 Other (specify) ft.
 SCREEN-PERFORATED INTERVALS: From 33 ft. to 63 ft., From ft. to ft.
 GRAVEL PACK INTERVALS: From 27.6 ft. to 63 ft., From ft. to ft.

6 GROUT MATERIAL: 1 Neat cement 2 Cement grout 3 Bentonite 4 Other: native soil
 Grout Intervals: From 0 ft. to 19 ft., From 21.9 ft. to 27.6 ft., From 19 ft. to 21.9 ft.
 What is the nearest source of possible contamination:
 1 Septic tank 4 Lateral lines 7 Pit privy 10 Livestock pens 14 Abandoned water well
 2 Sewer lines 5 Cess pool 8 Sewage lagoon 11 Fuel storage 15 Oil well/Gas well
 3 Watertight sewer lines 6 Seepage pit 9 Feedyard 12 Fertilizer storage 16 Other (specify below)
 13 Insecticide storage
 Direction from well? E How many feet? 50

FROM	TO	LITHOLOGIC LOG	FROM	TO	PLUGGING INTERVALS
0	0.75	silty loam, black, root frags			
0.75	4.25	silty clay, dark brown			
4.25	9	fine sand, red-brown			
9	11	fine sand, clayey, red-brown			
11	12	fine sand, red-brown			
12	21	clayey sand, tr caliche @ 21'			
21	28	sandy clay, brown, stiff			
28	31	sandy clay, red-brown			
31	45	silty clay, red-brown			
45	46	clay, soft, med br with lt. br. mottling			
46	50	silty clay, red-brown w/ olive gr. mottl			
50	63	silty clay, olive green-brown			

7 CONTRACTOR'S OR LANDOWNER'S CERTIFICATION: This water well was (1) constructed, (2) reconstructed, or (3) plugged under my jurisdiction and was completed on (mo/day/year) Oct 16, 2002 and this record is true to the best of my knowledge and belief. Kansas Water Well Contractor's Licence No This Water Well Record was completed on (mo/day/yr) Feb 24, 2003 under the business name of KDHE/BER by (signature) [Signature]