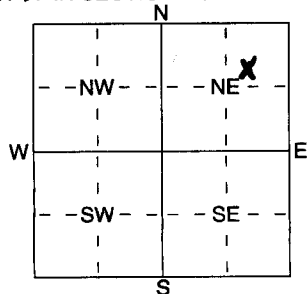


1 LOCATION OF WATER WELL:	Fraction	Section Number	Township Number	Range Number
County: Pratt	SW 1/4 SW 1/4 NE 1/4	33	T 27 S	R 13 E/W

Distance and direction from nearest town or city street address of well if located within city?

72281 Hwy & west into Driveway 1/8 west2 WATER WELL OWNER: **Bondic West**RR#, St. Address, Box # : **1226 Jackson**
City, State, ZIP Code : **Pratt KS 67124**Board of Agriculture, Division of Water Resources
Application Number: **NA**3 LOCATE WELL'S LOCATION WITH 4 DEPTH OF COMPLETED WELL **93** ft. ELEVATION:

AN "X" IN SECTION BOX:

Depth(s) Groundwater Encountered **1** ft. 2 ft. 3 ft.WELL'S STATIC WATER LEVEL **53** ft. below land surface measured on mo/day/yr **3-16-04**

Pump test data: Well water was ft. after hours pumping gpm

Est. Yield gpm: Well water was ft. after hours pumping gpm

WELL WATER TO BE USED AS: 5 Public water supply 8 Air conditioning 11 Injection well

X 1 Domestic 3 Feedlot 6 Oil field water supply 9 Dewatering 12 Other (Specify below)

2 Irrigation 4 Industrial 7 Domestic (lawn & garden) 10 Monitoring well

Was a chemical/bacteriological sample submitted to Department? Yes No **X**; If yes, mo/day/yr sample was submitted
Water Well Disinfected? Yes **X** No

5 TYPE OF BLANK CASING USED:

1 Steel 3 RMP (SR)

X 2 PVC 4 ABS

5 Wrought iron

6 Asbestos-Cement

7 Fiberglass

8 Concrete tile

9 Other (specify below)

CASING JOINTS: Glued **X** Clamped

Welded

Threaded

Blank casing diameter in. to **93** ft., Dia **150** in. to ft., Dia in. to ft.Casing height above land surface **12** in., weight lbs./ft. Wall thickness or gauge No.

TYPE OF SCREEN OR PERFORATION MATERIAL:

1 Steel 3 Stainless Steel

2 Brass 4 Galvanized Steel

5 Fiberglass

6 Concrete tile

X 7 PVC

8 RMP (SR)

9 ABS

10 Asbestos-Cement

11 Other (Specify)

12 None used (open hole)

SCREEN OR PERFORATION OPENINGS ARE:

1 Continuous slot 3 Mill slot

2 Louvered shutter 4 Key punched

5 Gauzed wrapped

6 Wire wrapped

7 Torch cut

X 8 Saw cut 11 None (open hole)

9 Drilled holes

10 Other (specify) ft.

SCREEN-PERFORATED INTERVALS: From **93** ft. to **73** ft., From ft. to ft.

From ft. to ft., From ft. to ft.

GRAVEL PACK INTERVALS: From **73** ft. to **20** ft., From ft. to ft.

From ft. to ft., From ft. to ft.

6 GROUT MATERIAL: 1 Neat cement 2 Cement grout X Bentonite 4 Other

Grout Intervals: From **20** ft. to **0** ft., From ft. to ft.

What is the nearest source of possible contamination:

1 Septic tank 4 Lateral lines

2 Sewer lines 5 Cess pool

3 Watertight sewer lines 6 Seepage pit

7 Pit privy

8 Sewage lagoon

9 Feedyard

X 10 Livestock pens 14 Abandoned water well

11 Fuel storage 15 Oil well/Gas well

12 Fertilizer storage 16 Other (specify below)

13 Insecticide storage

How many feet? **100**Direction from well? **SW**

FROM TO LITHOLOGIC LOG FROM TO PLUGGING INTERVALS

0 8 B16 Top Soil

8 15 Fine Sand

15 31 Coarse Sand

31 42 Tan Clay

42 80 Fine Sand

80 93 Coarse Sand

7 CONTRACTOR'S OR LANDOWNER'S CERTIFICATION: This water well was (1) constructed, (2) reconstructed, or (3) plugged under my jurisdiction and was completed on (mo/day/year) **3-16-04** and this record is true to the best of my knowledge and belief. KansasWater Well Contractor's Licence No **67124** This Water Well Record was completed on (mo/day/yr) **3-24-04**under the business name of **Crowd's Water Well LLC** by (signature) **John Crowd**