


1 LOCATION OF WATER WELL: County: **Pratt** Fraction: **SW 1/4 SE 1/4 SW 1/4** Section Number: **34** Township Number: **27 S** Range Number: **13 W**

Distance and direction from nearest town or city street address of well if located within city?  
**516 E. First Street, Pratt, Kansas**

2 WATER WELL OWNER: **Tucker Oil & Gas**  
**P.O. Box 63**  
 RR #, St. Address, Box #: **Kingman, KS 67068**  
 City, State, ZIP Code : Board of Agriculture, Division of Water Resources  
 Application Number:

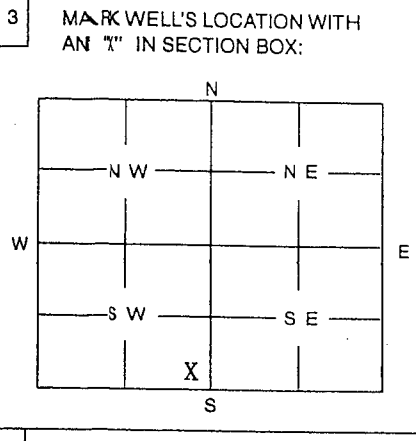

4 DEPTH OF WELL ..... **38** ..... ft.  
 WELL'S STATIC WATER LEVEL **n/a** ..... ft.  
 WELL WAS USED AS:  
 1 Domestic 2 Irrigation 3 Feedlot 4 Industrial 5 Public Water Supply 6 Oil Field Water Supply 7 Domestic (Lawn & Garden) 8 Air Conditioning 9 Dewatering 10 Monitoring Well 11 Injection Well 12 **Other** **Soil vapor extraction**  
 Was a chemical / bacteriological sample submitted to Department? Yes ..... No **X** .....  
 If yes, mo/day/yr sample was submitted .....  
 Water Well Disinfected: Yes ..... No **X** .....

5 TYPE OF BLANK CASING USED:  
 1 Steel 2 **PVC** 3 RMP (SR) 4 ABS 5 Wrought 6 Asbestos-Cement 7 Fiberglass 8 Concrete Tile 9 Other (Specify below) .....  
 Blank casing diameter ..... **2** ..... in. Was casing pulled? Yes ..... No **X** ..... If yes, how much **Overdrilled to 3'**  
 Casing height above or below land surface ..... **n/a** ..... in.

6 GROUT PLUG MATERIAL: 1 Neat cement 2 Cement grout 3 **Bentonite** 4 **Other** **Concrete / 4b Native soil**  
 Grout Plug Intervals: From **0** ft. to **0.5** ft., From **0.5** ft. to **3** ft., From **3** to **38** ft.

What is the nearest source of possible contamination:  
 1 Septic tank 2 Sewer lines 3 Watertight sewer lines 4 Lateral lines 5 Cess Pool 6 Seepage pit 7 Pit privy 8 Sewage lagoon 9 Feedyard 10 Livestock pens 11 Fuel storage 12 Fertilizer storage 13 Insecticide storage 14 Abandoned water well 15 Oil well/Gas well 16 **Other (specify below)** **Former UST basin**  
 Direction from well? **Northeast** How many feet? **80**

FROM	TO	PLUGGING MATERIALS
0	0.5	Concrete
0.5	3	Native soil (8")
3	38	Bentonite

SVE4

7 CONTRACTOR'S OR LANDOWNER'S CERTIFICATION: This water well was plugged under my jurisdiction and was completed on (mo/day/year) ..... **3/31/2004** ..... and this record is true to the best of my knowledge and belief. Kansas Water Well Contractor's License No. **527** This Water Well Record was completed on (mo/day/year) **4/1/2004** under the business name of **GeoCore Inc.**  
 by (signature) **Dola Kelly**

INSTRUCTIONS: Use typewriter or ball point pen. Please press firmly and print clearly. Please fill in blanks, underline or circle the correct answers. Send top three copies to Kansas Department of Health and Environment, Bureau of Water, Topeka, Kansas 66620-0001. Telephone: 785/296-3565. Send one to Water Well Owner and retain one for your records.