


1 LOCATION OF WATER WELL: Fraction Section Number Township Number Range Number  
 County: Pratt SW 1/4 SE 1/4 SW 1/4 34 27 S 13 W  
 Distance and direction from nearest town or city street address of well if located within city?  
 516 E. First Street, Pratt, Kansas

2 WATER WELLOWNER: Tucker Oil & Gas  
 P.O. Box 63  
 RR #, St. Address, Box #: Kingman, KS 67068  
 City, State, ZIP Code : Board of Agriculture, Division of Water Resources  
 Application Number:

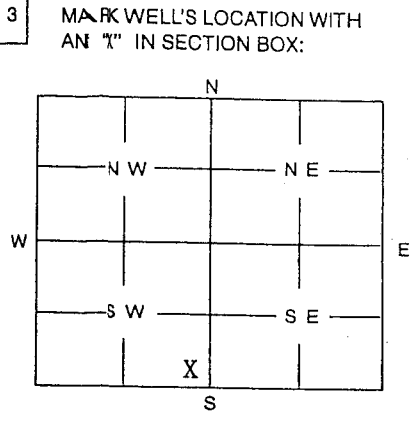

4 DEPTH OF WELL 43 ft  
 WELL'S STATIC WATER LEVEL n/a ft.  
 WELL WAS USED AS:  
 1 Domestic 5 Public Water Supply 9 Dewatering  
 2 Irrigation 6 Oil Field Water Supply 10 Monitoring Well  
 3 Feedlot 7 Domestic (Lawn & Garden) 11 Injection Well  
 4 Industrial 8 Air Conditioning 12 Other Soil vapor extraction  
 Was a chemical / bacteriological sample submitted to Department? Yes No X  
 If yes, mo/day/yr sample was submitted .....  
 Water Well Disinfected: Yes No X

5 TYPE OF BLANK CASING USED:  
 1 Steel 3 RMP (SR) 5 Wrought 7 Fiberglass 9 Other (Specify below)  
 2 PVC 4 ABS 6 Asbestos-Cement 8 Concrete Tile  
 Blank casing diameter 2 in. Was casing pulled? Yes No X  
 Casing height above or below land surface n/a in. If yes, how much Overdrilled to 3'

6 GROUT PLUG MATERIAL: 1 Neat cement 2 Cement grout 3 Bentonite 4 Other Concrete / 4b Native soil  
 Grout Plug Intervals: From 0 ft. to 0.5 ft., From 0.5 ft. to 3 ft., From 3 to 43 ft.  
 What is the nearest source of possible contamination:  
 1 Septic tank 6 Seepage pit 11 Fuel storage 12 Fertilizer storage 16 Other (specify below) Former USI basin  
 2 Sewer lines 7 Pit privy 13 Insecticide storage  
 3 Watertight sewer lines 8 Sewage lagoon 14 Abandoned water well  
 4 Lateral lines 9 Feedyard 15 Oil well/Gas well  
 5 Cess Pool 10 Livestock pens  
 Direction from well? North How many feet? 50

| FROM | TO  | PLUGGING MATERIALS |
|------|-----|--------------------|
| 0    | 0.5 | Concrete           |
| 0.5  | 3   | Native soil (8")   |
| 3    | 43  | Bentonite          |
|      |     |                    |
|      |     |                    |
|      |     |                    |

SVE1

7 CONTRACTOR'S OR LANDOWNER'S CERTIFICATION: This water well was plugged under my jurisdiction and was completed on (mo/day/year) 3/31/2004 and this record is true to the best of my knowledge and belief. Kansas Water Well Contractor's License No. 527 This Water Well Record was completed on (mo/day/year) 4/1/2004 under the business name of GeoCore Inc. by (signature) Dale Hall

INSTRUCTIONS: Use typewriter or ball point pen. Please press firmly and print clearly. Please fill in blanks, underline or circle the correct answers. Send top three copies to Kansas Department of Health and Environment, Bureau of Water, Topeka, Kansas 66620-0001. Telephone: 785/296-3565. Send one to Water Well Owner and retain one for your records.