


1	LOCATION OF WATER WELL: County: <u>Pratt</u>	Fraction SE <u>SW</u> 1/4 SE 1/4 SW 1/4	Section Number <u>34</u>	Township Number <u>27 S</u>	Range Number <u>13 W</u>
---	---	---	-----------------------------	--------------------------------	-----------------------------

Distance and direction from nearest town or city street address of well if located within city?
516 E. First Street, Pratt, Kansas

2	WATER WELLOWNER: <u>Tucker Oil & Gas</u> P.O. Box 63 RR #, St. Address, Box #: <u>Kingman, KS 67068</u> City, State, ZIP Code :	Board of Agriculture, Division of Water Resources Application Number:
---	--	--

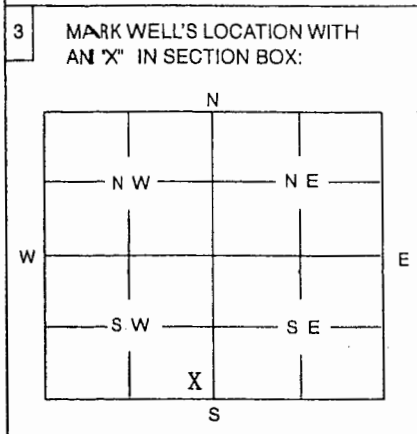

4 DEPTH OF WELL 50 ft

WELL'S STATIC WATER LEVEL ... Dry ft.

WELL WAS USED AS:

1 Domestic	5 Public Water Supply	9 Dewatering
2 Irrigation	6 Oil Field Water Supply	10 Monitoring Well
3 Feedlot	7 Domestic (Lawn & Garden)	11 Injection Well
4 Industrial	8 Air Conditioning	<input checked="" type="checkbox"/> 12 Other <u>Monitoring/ vapor extraction</u>

Was a chemical / bacteriological sample submitted to Department? Yes No

If yes, mo/day/yr sample was submitted

Water Well Disinfected: Yes No

5 TYPE OF BLANK CASING USED:

1 Steel	3 RMP (SR)	5 Wrought	7 Fiberglass	9 Other (Specify below)
<input checked="" type="checkbox"/> 2 PVC	4 ABS	6 Asbestos-Cement	8 Concrete Tile	

Blank casing diameter 2 in. Was casing pulled? Yes No

Casing height above or below land surface n/a in. If yes, how much Overdrilled to 3'

6 GROUT PLUG MATERIAL: 1 Neat cement 2 Cement grout 3 Bentonite 4 Other Rock / 4b. Native soil.

Grout Plug Intervals: From 0 ft. to 3 ft., From 3 ft. to 50 ft., From to ft.

What is the nearest source of possible contamination:

1 Septic tank	6 Seepage pit	11 Fuel storage	<input checked="" type="checkbox"/> 16 Other (specify below) <u>Former UST basin</u>
2 Sewer lines	7 Pit privy	12 Fertilizer storage	
3 Watertight sewer lines	8 Sewage lagoon	13 Insecticide storage	
4 Lateral lines	9 Feedyard	14 Abandoned water well	
5 Cess Pool	10 Livestock pens	15 Oil well/Gas well	

Direction from well? Directly beneath How many feet? 0

FROM	TO	PLUGGING MATERIALS
0	0.5	Rock
0.5	3	Native soil (8")
3	50	Bentonite

MW14

7 CONTRACTOR'S OR LANDOWNER'S CERTIFICATION: This water well was plugged under my jurisdiction and was completed on (mo/day/year) 3/30/2004 and this record is true to the best of my knowledge and belief. Kansas Water Well Contractor's License No. 527 This Water Well Record was completed on (mo/day/year) 4/1/2004 under the business name of GeoCore Inc. by (signature) Dale Kell

INSTRUCTIONS: Use typewriter or ball point pen. Please press firmly and print clearly. Please fill in blanks, underline or circle the correct answers. Send top three copies to Kansas Department of Health and Environment, Bureau of Water, Topeka, Kansas 66620-0001. Telephone: 785/296-3565. Send one to Water Well Owner and retain one for your records.