


1 LOCATION OF WATER WELL: Fraction Section Number Township Number Range Number
 County: Pratt SW 1/4 SE 1/4 SW 1/4 34 27 S 13 W

Distance and direction from nearest town or city street address of well if located within city?
 516 E. First Street, Pratt, Kansas

2 WATER WELLOWNER: Tucker Oil & Gas
 P.O. Box 63
 RR #, St. Address, Box #: Kingman, KS 67068
 City, State, ZIP Code : Board of Agriculture, Division of Water Resources
 Application Number:

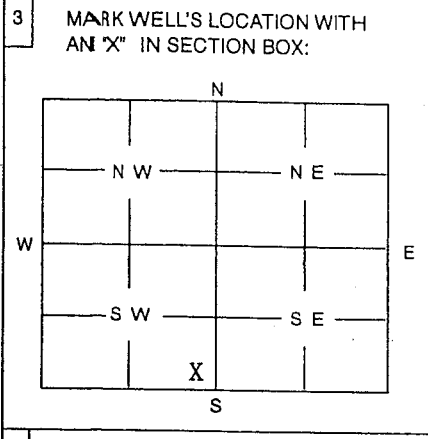

4 DEPTH OF WELL 57 ft
 WELL'S STATIC WATER LEVEL n/a ft.
 WELL WAS USED AS:
 1 Domestic 5 Public Water Supply 9 Dewatering
 2 Irrigation 6 Oil Field Water Supply 10 Monitoring Well
 3 Feedlot 7 Domestic (Lawn & Garden) 11 Injection Well
 4 Industrial 8 Air Conditioning 12 Other Air injection
 Was a chemical / bacteriological sample submitted to Department? Yes No X
 If yes, mo/day/yr sample was submitted
 Water Well Disinfected: Yes No X

5 TYPE OF BLANK CASING USED:
 1 Steel 3 RMP (SR) 5 Wrought 7 Fiberglass 9 Other (Specify below)
 PVC 4 ABS 6 Asbestos-Cement 8 Concrete Tile
 Blank casing diameter 1 in. Was casing pulled? Yes No X If yes, how much Overdrilled to 3'
 Casing height above or below land surface n/a in.

6 GROUT PLUG MATERIAL: 1 Neat cement 2 Cement grout Bentonite Other Concrete / 4b Native soil
 Grout Plug Intervals: From 0 ft. to 0.5 ft., From 0.5 ft. to 3 ft., From 3 to 57 ft.
 What is the nearest source of possible contamination:
 1 Septic tank 6 Seepage pit 11 Fuel storage Other (specify below) Former UST basin
 2 Sewer lines 7 Pit privy 12 Fertilizer storage
 3 Watertight sewer lines 8 Sewage lagoon 13 Insecticide storage
 4 Lateral lines 9 Feedyard 14 Abandoned water well
 5 Cess Pool 10 Livestock pens 15 Oil well/Gas well
 Direction from well? Northeast How many feet? 90

FROM	TO	PLUGGING MATERIALS
0	0.5	Concrete
0.5	3	Native soil (8")
3	57	Bentonite

ALL

7 CONTRACTOR'S OR LANDOWNER'S CERTIFICATION: This water well was plugged under my jurisdiction and was completed on (mo/day/year) 3/31/2004 and this record is true to the best of my knowledge and belief. Kansas Water Well Contractor's License No. 527 This Water Well Record was completed on (mo/day/year) 4/1/2004 under the business name of GeoCore Inc.
 by (signature) *Joe Bell*

INSTRUCTIONS: Use typewriter or ball point pen. Please press firmly and print clearly. Please fill in blanks, underline or circle the correct answers. Send top three copies to Kansas Department of Health and Environment, Bureau of Water, Topeka, Kansas 66620-0001. Telephone: 785/296-3565. Send one to Water Well Owner and retain one for your records.