


1 LOCATION OF WATER WELL: Fraction **SE ¼ SE ¼ SW ¼** Section Number **34** Township Number **T 27 S** Range Number **R 13 E4N**
 County: **Pratt**

Distance and direction from nearest town or city street address of well if located within city?

2 WATER WELL OWNER: **R. Kenneth Strothman**
 RR#, St. Address, Box #: **PO Box B** Board of Agriculture, Division of Water Resources
 City, State, ZIP Code: **Pratt, KS 67124** **OB-1** Application Number:

3 LOCATE WELL'S LOCATION WITH AN "X" IN SECTION BOX:

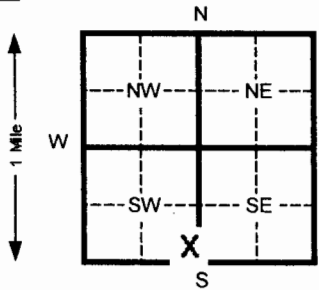

4 DEPTH OF COMPLETED WELL **55** ft. ELEVATION: **1880.64**
 Depth(s) Groundwater Encountered 1 _____ ft. 2 _____ ft. 3 _____ ft.
 WELL'S STATIC WATER LEVEL **42.73** ft. below land surface measured on mo/day/yr
 Pump test data: Well water was _____ ft. after _____ hours pumping _____ gpm
 Est. Yield _____ gpm: Well water was _____ ft. after _____ hours pumping _____ gpm
 Bore Hole Diameter **8** in. to **55** ft. and _____ in. to _____ ft.
 WELL WATER TO BE USED AS: 5 Public water supply 8 Air conditioning 11 Injection well
 1 Domestic 3 Feed lot 6 Oil field water supply 9 Dewatering 12 Other (Specify below) **Observation**
 2 Irrigation 4 Industrial 7 Lawn and garden (domestic) 10 Monitoring well
 Was a chemical/bacteriological sample submitted to Department? Yes _____ No If yes, mo/day/yr sample was submitted _____
 Water Well Disinfected? Yes _____ No

5 TYPE OF BLANK CASING USED:
 1 Steel 3 RMP (SR) 5 Wrought Iron 8 Concrete tile CASING JOINTS: Glued _____ Clamped _____
 2 PVC 4 ABS 6 Asbestos-Cement 9 Other (specify below) Welded _____
 7 Fiberglass Threaded X
 Blank casing diameter **4** in. to **30** ft., Dia _____ in. to _____ ft., Dia _____ in. to _____ ft.
 Casing height above land surface **0** in., weight **2.071** lbs./ft. Wall thickness or gauge No. **.237**
 TYPE OF SCREEN OR PERFORATION MATERIAL: 7 PVC 10 Asbestos-cement
 1 Steel 3 Stainless steel 5 Fiberglass 8 RMP (SR) 11 Other (specify) _____
 2 Brass 4 Galvanized steel 6 Concrete tile 9 ABS 12 None used (open hole)
 SCREEN OR PERFORATION OPENINGS ARE:
 1 Continuous slot 3 Mill slot 5 Gauzed wrapped 8 Saw cut 11 None (open hole)
 2 Louvered shutter 4 Key punched 7 Wire wrapped 9 Drilled holes
 10 Other (specify) _____
 SCREEN-PERFORATED INTERVALS: From **30** ft. to **55** ft. From _____ ft. to _____ ft.
 GRAVEL PACK INTERVALS: From **28** ft. to **55** ft. From _____ ft. to _____ ft.

6 GROUT MATERIAL: 1 Neat cement 2 Cement grout 3 Bentonite 4 Other _____
 Grout intervals From **0** ft. to **1** ft. From **28** ft. to _____ ft. From _____ ft. to _____ ft.
 What is the nearest source of possible contamination:
 1 Septic tank 4 Lateral lines 7 Pit privy 10 Livestock pens 14 Abandoned water well
 2 Sewer lines 5 Cess pool 8 Sewage lagoon 11 Fuel storage 15 Oil well/ Gas well
 3 Watertight sewer lines 6 Seepage pit 9 Feedyard 12 Fertilizer storage 16 Other (specify below) **Contaminated Site**
 13 Insecticide storage
 Direction from well? _____ How many feet? _____

FROM	TO	CODE	LITHOLOGIC LOG	FROM	TO	PLUGGING INTERVALS
0	.5		Cement			
.5	1		Backfill			
1	15		Red Sandy Clay			
15	24		Loose fine to Med Grained Sand			
24	30		Red & Gray Sandy Clay With Caliche			
30	35		Very Fine grained, very clayey Sand			
35	40		Red Sandy Clay to very fine Grained clayey Sand, w. Caliche			
40	45		Fine to very Fine Grained red Clayey Sand			
45	55		Loose Sand & gravel, Clayey			

7 CONTRACTOR'S OR LANDOWNER'S CERTIFICATION: This water well was (1) constructed, (2) reconstructed, or (3) plugged under my jurisdiction and was completed on (mo/day/yr) **07-21-04** and this record is true to the best of my knowledge and belief. Kansas
 Water Well Contractor's License No. **554** This Water Well Record was completed on (mo/day/yr) **08-09-04**
 under the business name of **Woofter Pump & Well, Inc.** by (signature) *James C. Woofter*

INSTRUCTIONS: Please fill in blanks and circle the correct answers. Send three copies to Kansas Department of Health and Environment, Bureau of Water, Topeka, Kansas 66620-0001. Telephone: 913-296-5545. Send one to WATER WELL OWNER and retain one for your records.

OFFICE USE ONLY
T
R
SEC