


1 LOCATION OF WATER WELL: County: Pratt Fraction: NW 1/4 NW 1/4 SW 1/4 Section Number: 33 Township Number: T 27 S Range Number: R 13 E0

Distance and direction from nearest town or city street address of well if located within city?  
NW of Pratt

2 WATER WELL OWNER: John Bost  
RR#, St. Address, Box #: 285 S. Pine Board of Agriculture, Division of Water Resources  
City, State, ZIP Code: Pratt, KS 67124 Application Number: 1003

3 LOCATE WELL'S LOCATION WITH AN "X" IN SECTION BOX: 4 DEPTH OF COMPLETED WELL: 99 ft. ELEVATION: \_\_\_\_\_ ft.  
Depth(s) Groundwater Encountered 1. \_\_\_\_\_ ft. 2. \_\_\_\_\_ ft. 3. \_\_\_\_\_ ft.

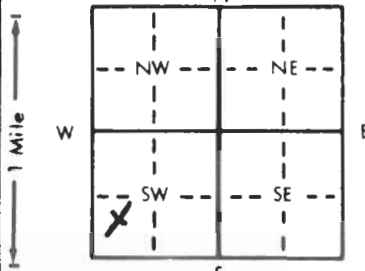

WELL'S STATIC WATER LEVEL: 68 ft. below land surface measured on mo/day/yr 3-21-05  
Pump test data: Well water was \_\_\_\_\_ ft. after \_\_\_\_\_ hours pumping \_\_\_\_\_ gpm  
Est. Yield \_\_\_\_\_ gpm: Well water was \_\_\_\_\_ ft. after \_\_\_\_\_ hours pumping \_\_\_\_\_ gpm  
Bore Hole Diameter: 10 in. to 99 ft., and \_\_\_\_\_ in. to \_\_\_\_\_ ft.  
WELL WATER TO BE USED AS:  
5 Public water supply 8 Air conditioning 11 Injection well  
1 Domestic 3 Feedlot 6 Oil field water supply 9 Dewatering 12 Other (Specify below)  
2 Irrigation 4 Industrial X 7 Lawn and garden only 10 Monitoring well  
Was a chemical/bacteriological sample submitted to Department? Yes \_\_\_\_\_ No X; If yes, mo/day/yr sample was submitted \_\_\_\_\_  
Water Well Disinfected? Yes X No \_\_\_\_\_

5 TYPE OF BLANK CASING USED:  
1 Steel 3 RMP (SR) 5 Wrought iron 8 Concrete tile CASING JOINTS: Glued X Clamped \_\_\_\_\_  
X 2 PVC 4 ABS 6 Asbestos-Cement 9 Other (specify below) Welded \_\_\_\_\_  
Blank casing diameter: 5 in. to 99 ft. Dia \_\_\_\_\_ in. to \_\_\_\_\_ ft. Dia \_\_\_\_\_ in. to \_\_\_\_\_ ft.  
Casing height above land surface: 12 in., weight 16 lbs./ft. Wall thickness or gauge No. \_\_\_\_\_  
TYPE OF SCREEN OR PERFORATION MATERIAL:  
1 Steel 3 Stainless steel 5 Fiberglass X PVC 10 Asbestos-cement  
2 Brass 4 Galvanized steel 6 Concrete tile 9 ABS 12 None used (open hole)

SCREEN OR PERFORATION OPENINGS ARE:  
X 1 Continuous slot 3 Mill slot 5 Gauzed wrapped 8 Saw cut 11 None (open hole)  
2 Louvered shutter 4 Key punched 6 Wire wrapped 9 Drilled holes  
SCREEN-PERFORATED INTERVALS: From: 99 ft. to BOA ft., From: 5 ft. to 27 ft.  
From: \_\_\_\_\_ ft. to \_\_\_\_\_ ft., From: \_\_\_\_\_ ft. to \_\_\_\_\_ ft.  
GRAVEL PACK INTERVALS: From: 99 ft. to 22 30 ft., From: 22 ft. to \_\_\_\_\_ ft.  
From: \_\_\_\_\_ ft. to \_\_\_\_\_ ft., From: \_\_\_\_\_ ft. to \_\_\_\_\_ ft.

6 GROUT MATERIAL: 1 Neat cement 2 Cement grout X 3 Bentonite 4 Other \_\_\_\_\_  
Grout Intervals: From: 32 ft. to 30 ft., From: 22 ft. to 0 ft., From: \_\_\_\_\_ ft. to \_\_\_\_\_ ft.  
What is the nearest source of possible contamination:  
1 Septic tank 4 Lateral lines 7 Pit privy 10 Livestock pens 14 Abandoned water well  
2 Sewer lines 5 Cess pool 8 Sewage lagoon 11 Fuel storage 15 Oil well/Gas well  
3 Watertight sewer lines 6 Seepage pit 9 Feedyard 12 Fertilizer storage 16 Other (specify below)  
13 Insecticide storage Nothing  
Direction from well? \_\_\_\_\_ How many feet? \_\_\_\_\_

FROM	TO	LITHOLOGIC LOG	FROM	TO	PLUGGING INTERVALS
0	5	BLACK TOP SOIL			
5	25	Tan sand			
25	40	Bk Clay			
40	55	Fine sand			
55	75	COARSE SAND			
75	85	Tan Clay			
85	99	COARSE SAND			

7 CONTRACTOR'S OR LANDOWNER'S CERTIFICATION: This water well was X (1) constructed, (2) reconstructed, or (3) plugged under my jurisdiction and was completed on (mo/day/year) 3-21-05 and this record is true to the best of my knowledge and belief. Kansas Water Well Contractor's License No. \_\_\_\_\_ This Water Well Record was completed on (mo/day/yr) 3-25-05 under the business name of Crowdis Water Well by (signature) [Signature]