


KONE

1	LOCATION OF WATER WELL:	Fraction	Section	Number	Township	Number	Range	Number
County:	Pratt	Sec 1/4 Sec 2 NE	B		275		13	EW

Distance and direction from nearest town or city street address of well if located within city?
North East of Pratt on Hwy 61 + 30th Ave turn west into field.

2	WATER WELL OWNER:	Board of Agriculture, Division of Water Resources
	RR #, St. Address, Box #:	Application Number:
	City, State, ZIP Code:	
	Wildcat Bio. Energy	
	1320 E. 1st Box 355	
	Pratt KS 67124	

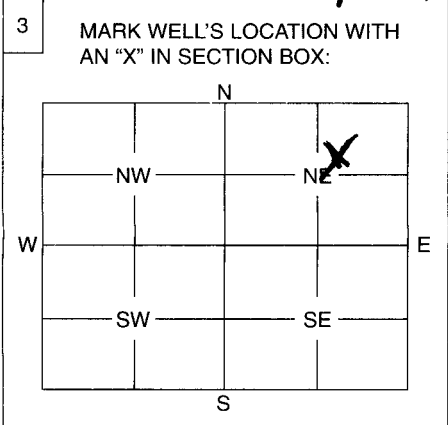

4	DEPTH OF WELL	80	ft.
	WELL'S STATIC WATER LEVEL	None	ft.
WELL WAS USED AS:			
1	Domestic	5	Public Water Supply
2	Irrigation	6	Oil Field Water Supply
3	Feedlot	7	Domestic (Lawn & Garden)
4	Industrial	8	Air Conditioning
		9	Dewatering
		10	Monitoring Well
		11	Injection Well
		12	Other
			NA
Was a chemical / bacteriological sample submitted to Department? Yes No <input checked="" type="checkbox"/>			
If yes, mo/day/yr sample was submitted			
Water Well Disinfected: Yes <input checked="" type="checkbox"/> No			

5	TYPE OF BLANK CASING USED:								
<input checked="" type="checkbox"/>	1 Steel	<input type="checkbox"/>	3 RMP (SR)	<input type="checkbox"/>	5 Wrought	<input type="checkbox"/>	7 Fiberglass	<input type="checkbox"/>	9 Other (Specify below)
<input type="checkbox"/>	2 PVC	<input type="checkbox"/>	4 ABS	<input type="checkbox"/>	6 Asbestos-Cement	<input type="checkbox"/>	8 Concrete Tile		
Blank casing diameter		5	in.		Was casing pulled?		Yes	No <input checked="" type="checkbox"/>	If yes, how much
Casing height above or below land surface		72	in.						

6	GROUT PLUG MATERIAL:	1 Neat cement	2 Cement grout	<input checked="" type="checkbox"/>	3 Bentonite	4 Other	
Grout Plug Intervals:		From 80	ft. to 74	ft.,	From	to	
What is the nearest source of possible contamination:							
1	Septic tank	6	Seepage pit	11	Fuel storage	16	Other (specify below)
2	Sewer lines	7	Pit privy	12	Fertilizer storage	Nothing	
3	Watertight sewer lines	8	Sewage lagoon	13	Insecticide storage		
4	Lateral lines	9	Feedyard	14	Abandoned water well		
5	Cess pool	10	Livestock pens	15	Oil well/Gas well		
Direction from well?		How many feet?					

FROM	TO	PLUGGING MATERIALS
0	4	Clay Dirt
4	80	Bentonite

7	CONTRACTOR'S OR LANDOWNER'S CERTIFICATION: This water well was plugged under my jurisdiction and was completed on (mo/day/year) 4-26-05 and this record is true to the best of my knowledge and belief. Kansas Water Well Contractor's License No. 672 This Water Well Record was completed on (mo/day/year) 5-6-05 under the business name of Crowds Water Well by (signature) Tom Crowds
---	--

INSTRUCTIONS: Use typewriter or ball point pen. Please press firmly and print clearly. Please fill in blanks, underline or circle the correct answers. Send top three copies to Kansas Department of Health and Environment, Bureau of Water, Geology Section, 1000 SW Jackson St., Ste. 420, Topeka, Kansas 66612-1367. Telephone: 785/296-5522. Send one to Water Well Owner and retain one for your records.