

1	LOCATION OF WATER WELL:	Fraction	Section Number	Township Number	Range Number
County: Pratt		$\frac{1}{4}$ NE $\frac{1}{4}$ NW $\frac{1}{4}$ NE	35	T 27 S	R 13 E W

Distance and direction from nearest town or city street address of well if located within city?

1/2 mile east of Hwy 61 on 10th Street, Pratt, KS


2	WATER WELL OWNER: South Wind Hospice
---	--------------------------------------

RR#, St. Address, Box # : 496 Yucca Ln
City, State, ZIP Code : Pratt, KS 67124

Board of Agriculture, Division of Water Resources
Application Number:

3	LOCATE WELL'S LOCATION WITH	4	DEPTH OF COMPLETED WELL 106.3 ft. ELEVATION:
---	-----------------------------	---	--

AN "X" IN SECTION BOX:

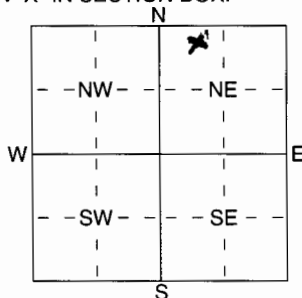

Depth(s) Groundwater Encountered 1 ft. 2 ft. 3 ft.
WELL'S STATIC WATER LEVEL 65.1 ft. below land surface measured on mo/day/yr 09-21-05

Pump test data: Well water was ft. after hours pumping gpm
 Est. Yield 60 gpm: Well water was ft. after hours pumping gpm

WELL WATER TO BE USED AS:

1 Domestic	3 Feedlot	5 Public water supply	8 Air conditioning	11 Injection well
2 Irrigation	4 Industrial	6 Oil field water supply	9 Dewatering	12 Other (Specify below)
		7 Domestic (lawn & garden)	10 Monitoring well	

Was a chemical/bacteriological sample submitted to Department? Yes No **X**... ; If yes, mo/day/yr sample was submitted
Water Well Disinfected? Yes No **X**.....

5	TYPE OF BLANK CASING USED:
---	----------------------------

5 Wrought iron	8 Concrete tile
6 Asbestos-Cement	9 Other (specify below)
7 Fiberglass

CASING JOINTS: Glued X Clamped
 Welded
 Threaded

Blank casing diameter 5" in. to 66.3 ft. Dia in. to ft. Dia in. to ft.

Casing height above land surface 18" in., weight Sch 160 lbs./ft. Wall thickness or gauge No.

TYPE OF SCREEN OR PERFORATION MATERIAL:

5 Fiberglass	8 RMP (SR)
6 Concrete tile	9 ABS

10 Asbestos-Cement
11 Other (Specify)
12 None used (open hole)

SCREEN OR PERFORATION OPENINGS ARE:

- 5 Guazed wrapped
- 6 Wire wrapped
- 7 Torch cut

8 Saw cut
9 Drilled holes
10 Other (specify)ft.
11 None (open hole)

1 Continuous slot
2 Louvered shutter
3 Mill slot .025
4 Key punched

SCREEN-PERFORATED INTERVALS: From 66.3 ft. to 106.3 ft., From ft. to ft.
From ft. to ft., From ft. to ft.

GRAVEL PACK INTERVALS: From 106.3 ft. to 58.5 ft., From _____ ft. to _____ ft.
From _____ ft. to _____ ft., From _____ ft. to _____ ft.

10/20

6 GROUT MATERIAL: 1 Neat cement 2 Cement grout 3 Bentonite 4 Other.....
Grout Intervals: From 58.5 ft. to 0 ft. From ft. to ft. From ft. to ft.

What is the nearest source of possible contamination:

1 Septic tank	4 Lateral lines	7 Pit privy	11 Fuel storage	15 Oil well/Gas well
2 Sewer lines	5 Cess pool	8 Sewage lagoon	12 Fertilizer storage	16 Other (specify below)
3 Watertight sewer lines	6 Seepage pit	9 Feedyard	13 Insecticide storage Drainage

Direction from well? Southeast

[illegible]

7] CONTRACTOR'S OR LANDOWNER'S CERTIFICATION: This water well was (1) constructed, (2) reconstructed, or (3) plugged under my jurisdiction and was completed on (mo/day/year) 09-20-05 and this record is true to the best of my knowledge and belief. Kansas Water Well Contractor's Licence No. 665 This Water Well Record was completed on (mo/day/yr) 09-21-05 under the business name of Pratt Well Environmental by (signature) Steven Pratt