


MW 3

1	LOCATION OF WATER WELL: County: <u>Pratt</u>	Fraction <u>NN 1/4 SE 3/4</u>	Section Number <u>9</u>	Township Number <u>27</u>	Range Number <u>13</u>
---	---	----------------------------------	----------------------------	------------------------------	---------------------------

Distance and direction from nearest town or city street address of well if located within city?
40116 Runway Boulevard, Pratt, KS 67124

2 WATER WELL OWNER: Pratt Ag Aviation, Inc.
Sharon Cleveland
RR #, St. Address, Box #: 581 Sunrise Ave
City, State, ZIP Code : Pratt, KS 67124

Board of Agriculture, Division of Water Resources
Application Number: _____

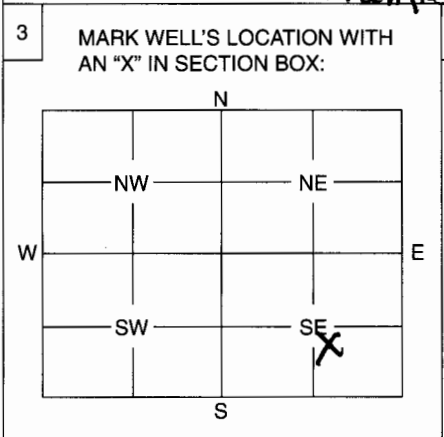

4 DEPTH OF WELL 60 ft.
WELL'S STATIC WATER LEVEL 48.26 ft.

WELL WAS USED AS:

1 Domestic	5 Public Water Supply	9 Dewatering
2 Irrigation	6 Oil Field Water Supply	<u>10 Monitoring Well</u>
3 Feedlot	7 Domestic (Lawn & Garden)	11 Injection Well
4 Industrial	8 Air Conditioning	12 Other

Was a chemical / bacteriological sample submitted to Department? Yes No X.....
If yes, mo/day/yr sample was submitted

Water Well Disinfected: Yes No X.....

5 TYPE OF BLANK CASING USED:

1 Steel	3 RMP (SR)	5 Wrought	7 Fiberglass	9 Other (Specify below)
2 PVC	4 ABS	6 Asbestos-Cement	8 Concrete Tile	

Blank casing diameter 2 in. Was casing pulled? Yes No X..... If yes, how much

Casing height above or below ground surface 16 in.

6 GROUT PLUG MATERIAL: 1 Neat cement 2 Cement grout 3 Bentonite 4 Other

Grout Plug Intervals: From 3 ft. to 60 ft., From ft. to ft., From to ft.

What is the nearest source of possible contamination:

1 Septic tank	6 Seepage pit	11 Fuel storage	<u>16 Other (specify below)</u>
2 Sewer lines	7 Pit privy	12 Fertilizer storage	<u>Just site</u>
3 Watertight sewer lines	8 Sewage lagoon	13 Insecticide storage	
4 Lateral lines	9 Feedyard	14 Abandoned water well	
5 Cess pool	10 Livestock pens	15 Oil well/Gas well	

Direction from well? How many feet?

FROM	TO	PLUGGING MATERIALS
<u>0</u>	<u>3</u>	<u>Concrete</u>
<u>3</u>	<u>60</u>	<u>20-30% solids bentonite</u>

7 CONTRACTOR'S OF LANDOWNER'S CERTIFICATION: This water well was plugged under my jurisdiction and was completed on (mo/day/year) 07-10-06 and this record is true to the best of my knowledge and belief. Kansas Water Well Contractor's License No. 594 This Water Well Record was completed on (mo/day/year) 07-10-06 under the business name of Coranco Erect Plugs, Inc. by (signature) Miguel E. Delmundo

INSTRUCTIONS: Use typewriter or ball point pen. Please press firmly and print clearly. Please fill in blanks, underline or circle the correct answers. Send top three copies to Kansas Department of Health and Environment, Bureau of Water, Geology Section, 1000 SW Jackson St., Ste. 420, Topeka, Kansas 66612-1367. Telephone: 785/296-5522. Send one to Water Well Owner and retain one for your records.