


VORWI

1	LOCATION OF WATER WELL: County: Pratt	Fraction NN 1/4 SE 1/4 SE 1/4	Section Number 9	Township Number 27	Range Number 13
---	---	---	----------------------------	------------------------------	---------------------------

Distance and direction from nearest town or city street address of well if located within city?
40116 Runway Boulevard, Pratt, KS 67124

2	WATER WELL OWNER: RR #, St. Address, Box #: Pratt Ag Aviation, Inc. Sharon Cleverger 581 Sunrise Ave. City, State, ZIP Code : Pratt, KS 67124	Board of Agriculture, Division of Water Resources Application Number:
---	---	--

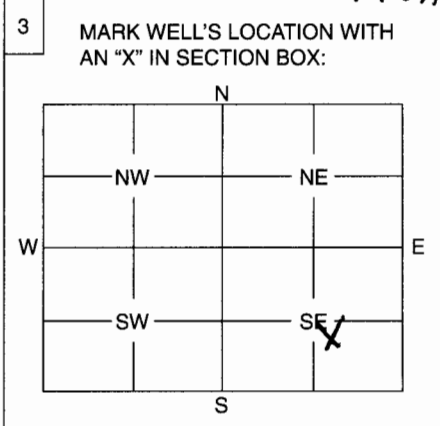

4	DEPTH OF WELL 55 ft. WELL'S STATIC WATER LEVEL 49.94 ft. WELL WAS USED AS: 1 Domestic 2 Irrigation 3 Feedlot 4 Industrial 5 Public Water Supply 6 Oil Field Water Supply 7 Domestic (Lawn & Garden) 8 Air Conditioning 9 Dewatering 10 Monitoring Well 11 Injection Well 12 Other Vapor Obstruction Well
Was a chemical / bacteriological sample submitted to Department? Yes No X	
If yes, mo/day/yr sample was submitted	
Water Well Disinfected: Yes No X	

5	TYPE OF BLANK CASING USED: 1 Steel 2 PVC 3 RMP (SR) 4 ABS 5 Wrought 6 Asbestos-Cement 7 Fiberglass 8 Concrete Tile 9 Other (Specify below)
Blank casing diameter 4 in. Was casing pulled? Yes No If yes, how much	
Casing height above or below land surface 6 in.	

6	GROUT PLUG MATERIAL: 1 Neat cement 2 Cement grout 3 Bentonite 4 Other
Grout Plug Intervals: From 3 ft. to 55 ft., From ft. to ft., From to ft.	
What is the nearest source of possible contamination: 1 Septic tank 2 Sewer lines 3 Watertight sewer lines 4 Lateral lines 5 Cess pool 6 Seepage pit 7 Pit privy 8 Sewage lagoon 9 Feedyard 10 Livestock pens 11 Fuel storage 12 Fertilizer storage 13 Insecticide storage 14 Abandoned water well 15 Oil well/Gas well 16 Other (specify below) LUST SITE	
Direction from well? How many feet?	

FROM	TO	PLUGGING MATERIALS
0	3	Concrete
3	55	20-30% Solids Bentonite Benseal

7	CONTRACTOR'S OR LANDOWNER'S CERTIFICATION: This water well was plugged under my jurisdiction and was completed on (mo/day/year) 07-10-08 and this record is true to the best of my knowledge and belief. Kansas Water Well Contractor's License No. 594 This Water Well Record was completed on (mo/day/year) 08-10-08 under the business name of Corance Great Plains, Inc. by (signature) Melvin E. Quinn
---	---

INSTRUCTIONS: Use typewriter or ball point pen. Please press firmly and print clearly. Please fill in blanks, underline or circle the correct answers. Send top three copies to Kansas Department of Health and Environment, Bureau of Water, Geology Section, 1000 SW Jackson St., Ste. 420, Topeka, Kansas 66612-1367. Telephone: 785/296-5522. Send one to Water Well Owner and retain one for your records.