


1 LOCATION OF WATER WELL: Fraction SW 1/4 SW 1/4 NW 1/4 Section Number 34 Township Number T 27 S Range Number R 13 **PLW**
 County: Pratt

Distance and direction from nearest town or city street address of well if located within city?
The Church of Jesus Christ Latter-Day Saints

2 WATER WELL OWNER: Pratt WWR
 RR#, St. Address, Box # : 1100 State Street
 City, State, ZIP Code : Pratt, KS 67124
 Board of Agriculture, Division of Water Resources
 Application Number:

3 LOCATE WELL'S LOCATION WITH AN "X" IN SECTION BOX: DEPTH OF COMPLETED WELL 115 ft. ELEVATION: 115

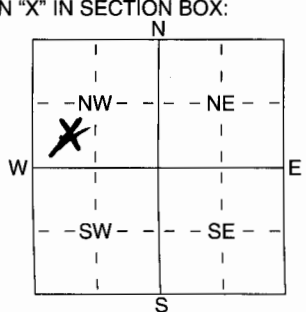

Depth(s) Groundwater Encountered 1. 71 ft. 2. 71 ft. 3. 71 ft.
 WELL'S STATIC WATER LEVEL 71 ft. below land surface measured on 1-9-07 mo/day/yr.
 Pump test data: Well water was 71 ft. after 1 hours pumping 115 gpm
 Est. Yield 115 gpm: Well water was 71 ft. after 1 hours pumping 115 gpm
 WELL WATER TO BE USED AS:
 1 Domestic 2 Irrigation 3 Feedlot 4 Industrial 5 Public water supply 6 Oil field water supply 7 Domestic (lawn & garden) 8 Air conditioning 9 Dewatering 10 Monitoring well 11 Injection well 12 Other (Specify below)

Was a chemical/bacteriological sample submitted to Department? Yes X No ; If yes 1 mo/day/yr sample was submitted
 Water Well Disinfected? Yes X No

5 TYPE OF BLANK CASING USED:
 1 Steel 2 Brass 3 Stainless Steel 4 Galvanized Steel 5 Wrought iron 6 Concrete tile 7 Fiberglass 8 RMP (SR) 9 ABS 10 Asbestos-Cement 11 Other (Specify) 12 None used (open hole)
 Blank casing diameter 5 in. to 115 ft. Dia 160 in. to 160 ft. Dia 160 in. to 160 ft. Dia
 Casing height above land surface 12 in., weight 160 lbs./ft. Wall thickness or gauge No.
 CASING JOINTS: Glued Clamped Welded Threaded

TYPE OF SCREEN OR PERFORATION MATERIAL:
 1 Steel 2 Brass 3 Stainless Steel 4 Galvanized Steel 5 Fiberglass 6 Concrete tile 7 PVC 8 RMP (SR) 9 ABS 10 Asbestos-Cement 11 Other (Specify) 12 None used (open hole)
 SCREEN OR PERFORATION OPENINGS ARE:
 1 Continuous slot 2 Louvered shutter 3 Mill slot 4 Key punched 5 Gauzed wrapped 6 Wire wrapped 7 Torch cut 8 Saw cut 9 Drilled holes 10 Other (specify) 11 None (open hole)

SCREEN-PERFORATED INTERVALS: From 115 ft. to 95 ft., From ft. to ft., From ft. to ft.
 GRAVEL PACK INTERVALS: From 115 ft. to 58 ft., From 50 ft. to 20 ft., From ft. to ft.

6 GROUT MATERIAL: 1 Neat cement 2 Cement grout 3 Bentonite 4 Other
 Grout Intervals: From 58 ft. to 50 ft., From 20 ft. to 0 ft., From ft. to ft.

What is the nearest source of possible contamination:
 1 Septic tank 2 Sewer lines 3 Watertight sewer lines 4 Lateral lines 5 Cess pool 6 Seepage pit 7 Pit privy 8 Sewage lagoon 9 Feedyard 10 Livestock pens 11 Fuel storage 12 Fertilizer storage 13 Insecticide storage 14 Abandoned water well 15 Oil well/Gas well 16 Other (specify below)
 Direction from well? East How many feet? 100

FROM	TO	LITHOLOGIC LOG	FROM	TO	PLUGGING INTERVALS
0	5	Block Top Soil			
5	21	Block Top Soil TAN clay			
21	38	Block Top Soil FINE SAND			
38	57	TAN clay			
57	58	White Clay			
58	78	Coarse Sand			
78	100	Small Gravel			
100	115	Coarse Gravel			

7 CONTRACTOR'S OR LANDOWNER'S CERTIFICATION: This water well was (1) constructed, (2) reconstructed, or (3) plugged under my jurisdiction and was completed on (mo/day/year) 1-9-07 and this record is true to the best of my knowledge and belief. Kansas Water Well Contractor's Licence No. 672 This Water Well Record was completed on (mo/day/yr) 1-30-07 under the business name of Chow's Water Well by (signature) [Signature]