


SITE NUMBER : 37 (KP12)
SITE LOCATION : NW NE SW
LEGAL LOCATION: 5-27-13W
COUNTY : PRATT

LANDOWNER: JERRY MOTT
ADDRESS : RT. 1
IUKA, KS 67066
PHONE NO.: (316)-546-2576

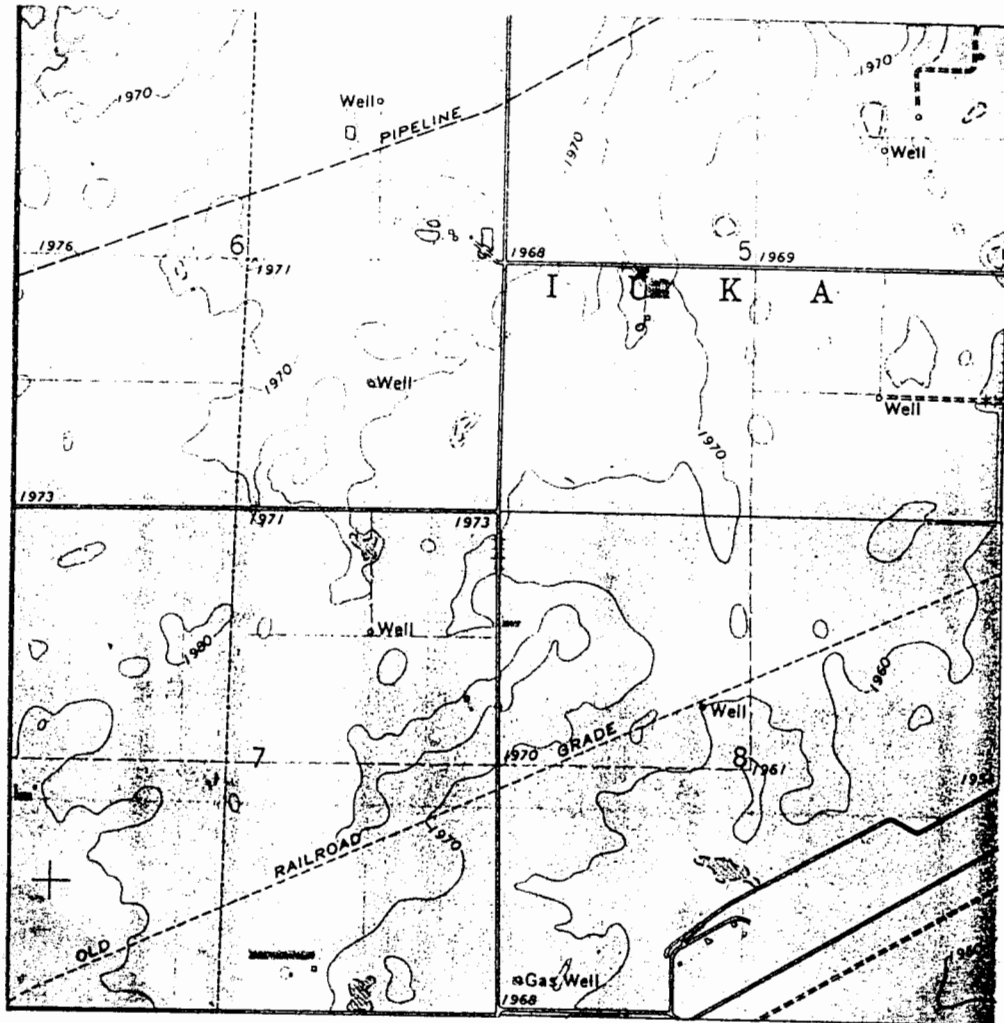

WELL LOCATION ✕

COATS NE QUADRANGLE
KANSAS-PRATT CO.
7.5 MINUTE SERIES (TOPOGRAPHI

517 R. 14 W. 518 47'30" R. 13 W. 519 | 1 920 000 FEET 521 9

