


1) LOCATION OF WATER WELL: County: Pratt	Fraction SE 1/4 SE 1/4 NW 1/4	Section Number 3	Township Number T 27 S	Range Number R 13 EW
--	---	----------------------------	----------------------------------	---------------------------------------

Distance and direction from nearest town or city street address of well if located within city?

300' South of Iuka Coop, Iuka, KS

2) WATER WELL OWNER: Iuka Co-op Exchange RR#, St. Address, Box # : 102 N. Main City, State, ZIP Code : Iuka, Kansas	Board of Agriculture, Division of Water Resources Application Number:
--	--

3) LOCATE WELL'S LOCATION WITH AN "X" IN SECTION BOX:

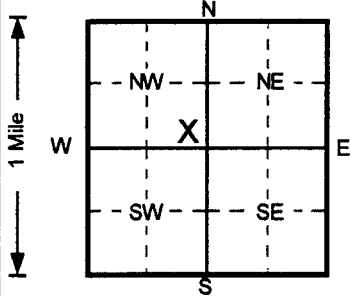

4) DEPTH OF COMPLETED WELL: **60** ft. ELEVATION: **0**

Depth(s) Groundwater Encountered 1. _____ ft. 2. _____ ft. 3. _____ ft.

WELL'S STATIC WATER LEVEL _____ ft. below land surface measured on mo/day/yr _____

Pump test data: Well water was **NA** ft. after _____ hours pumping _____ gpm

Est. Yield **NA** gpm: Well water was _____ ft. after _____ hours pumping _____ gpm

Bore Hole Diameter **8** in. to **60** ft., and _____ in. to _____ ft.

WELL WATER TO BE USED AS:

5 Public water supply	8 Air conditioning	11 Injection well
1 Domestic	3 Feedlot	6 Oil field water supply
2 Irrigation	4 Industrial	7 Lawn and garden only
		10 Monitoring well
		12 Other (Specify below)

Was a chemical/bacteriological sample submitted to Department? Yes _____ No _____; If yes, mo/day/yr sample was submitted _____

Water Well Disinfected? Yes _____ No _____

5) TYPE OF BLANK CASING USED:

1 Steel	3 RMP (SR)	5 Wrought iron	8 Concrete tile	CASING JOINTS: Glued _____ Clamped _____
2 PVC	4 ABS	6 Asbestos-Cement	9 Other (specify below)	Welded _____
		7 Fiberglass		Threaded <input checked="" type="checkbox"/>

Blank casing diameter **2** in. to **40** ft., Dia _____ in. to _____ ft., Dia _____ in. to _____ ft.

Casing height above land surface **36** in., weight **Sch 40** lbs./ft. Wall thickness or gauge No. _____

TYPE OF SCREEN OR PERFORATION MATERIAL:

1 Steel	3 Stainless steel	5 Fiberglass	7 PVC	10 Asbestos-cement
2 Brass	4 Galvanized steel	6 Concrete tile	8 RMP (SR)	11 Other (specify) _____
			9 ABS	12 None used (open hole)

SCREEN OR PERFORATION OPENINGS ARE:

1 Continuous slot	3 Mill slot	5 Gauzed wrapped	8 Saw cut	11 None (open hole)
2 Louvered shutter	4 Key punched	6 Wire wrapped	9 Drilled holes	
		7 Torch cut	10 Other (specify) _____	

SCREEN-PERFORATED INTERVALS: From **40** ft. to **60** ft., From _____ ft. to _____ ft.

GRAVEL PACK INTERVALS: From **38** ft. to **60** ft., From _____ ft. to _____ ft.

6) GROUT MATERIAL: 1 Neat cement **2 Cement grout** **3 Bentonite** 4 Other _____

Grout Intervals: From **0** ft. to **36** ft., From **36** ft. to **38** ft., From _____ ft. to _____ ft.

What is the nearest source of possible contamination:

1 Septic tank	4 Lateral lines	7 Pit privy	10 Livestock pens	14 Abandoned water well
2 Sewer lines	5 Cess pool	8 Sewage lagoon	11 Fuel storage	15 Oil well/Gas well
3 Watertight sewer lines	6 Seepage pit	9 Feedyard	12 Fertilizer storage	16 Other (specify below)
			13 Insecticide storage	

Direction from well? _____ How many feet? **0**

FROM	TO	LITHOLOGIC LOG	FROM	TO	PLUGGING INTERVALS
0	2	Clay, Dark Brown			
2	6	Clay, Red Brown			
6	10	Sand, Red Brown			
10	27	Clay, Red Brown			
27	30	Sand, Red Brown			
30	41	Clay, Red Brown			
41	50	Silt, Light Brown			
50	57	Sand, Light Brown			
57	60	Clay, Red Brown			
					MW19, Abovegrade
					Project Name: AG_W - Iuka
					GeoCore # 703, #

7) CONTRACTOR'S OR LANDOWNER'S CERTIFICATION: This water well was **(1)** constructed, **(2)** reconstructed, or **(3)** plugged under my jurisdiction and was completed on (mo/day/year) **8/18/1998** and this record is true to the best of my knowledge and belief.

Kansas Water Well Contractor's License No. **527** This Water Well Record was completed on (mo/day/yr) _____ under the business name of **GeoCore Services, Inc.** by (signature) *[Signature]*