


WATER WELL RECORD Form WWC-5 KSA 82a-1212

1 LOCATION OF WATER WELL: County: Pratt Fraction NE 1/4 NE 1/4 NW 1/4 Section Number 34 Township Number T 27 S Range Number R 13 E/W

Distance and direction from nearest town or city street address of well if located within city? 516 E. 1st St.; Pratt, Kansas

2 WATER WELL OWNER: Tucker Oil & Gas RR#: St. Address, Box#: P.O. Box 63 City, State, ZIP Code: Kingman, Kansas 67068 Board of Agriculture, Division of Water Resources Application Number:

3 LOCATE WELL'S LOCATION WITH AN "X" IN SECTION BOX:

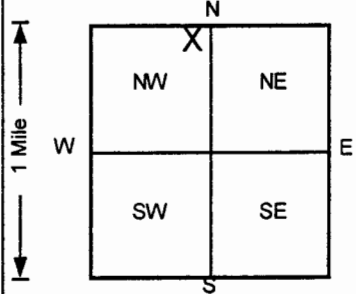

4 DEPTH OF COMPLETED WELL: 57 ft. ELEVATION: 1880.07. WELL'S STATIC WATER LEVEL: ft. below land surface measured on mo/day/yr. Pump test data: Well water was NA ft. after hours pumping gpm. Est. Yield: NA gpm. Well water was ft. after hours pumping gpm. Bore Hole Diameter: 8 in. to 57 ft. and in. to ft. WELL WATER TO BE USED AS: 12 Other (Specify below) Air injection well.

5 TYPE OF BLANK CASING USED: 2 PVC. CASING JOINTS: Threaded. TYPE OF SCREEN OR PERFORATION MATERIAL: 7 PVC. SCREEN OR PERFORATION OPENINGS ARE: 3 Mill slot. SCREEN-PERFORATED INTERVALS: From 52 ft to 57 ft. GRAVEL PACK INTERVALS: From 44 ft to 57 ft.

6 GROUT MATERIAL: 2 Cement grout, 3 Bentonite. Grout intervals: From 0 ft to 40 ft, From 40 ft to 44 ft. What is the nearest source of possible contamination: 16 Other (specify below) Former UST basin. Direction from well? Northwest. How many feet? 225

Table with columns: FROM, TO, LITHOLOGIC LOG, FROM, TO, PLUGGING INTERVALS. Rows list geological layers: Concrete, Clay, Dark Brown, Clay, Orange Brown, Clay, Orange Brown, Clay, Orange Brown/Brown, Sand, Brown, Sand, Brown, AI-5, Tag # 265371, Flushmount, Project Name: Willie's 66, GeoCore # 577, KDHE # U1 076 488

7 CONTRACTOR'S OR LANDOWNER'S CERTIFICATION: This water well was constructed, reconstructed, or plugged under my jurisdiction and was completed on 1/7/98 and this record is true to the best of my knowledge and belief. Kansas Water Well Contractor's License No. 527. This Water Well Record was completed on 4/29/98 under the business name of GeoCore Services, Inc. by (signature) Bob Koll