

USE TYPEWRITER OR BALL POINT PEN-PRESS FIRMLY, PRINT CLEARLY.

T R EW sec 1/4 1/4 1/4 No.

WATER WELL RECORD
KSA 82a-1201-1215

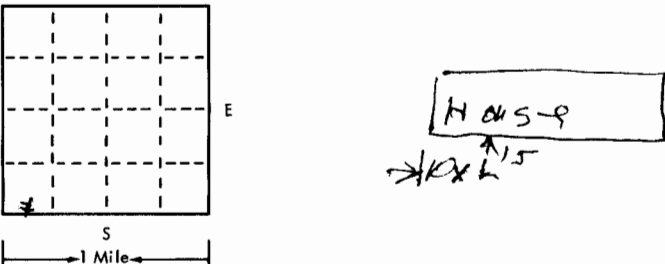
Kansas State Dept. Of Health
(Water Well Contractors)
Forbes-Bldg. 740
Topeka, Kansas 66620

52 SW NW

3

27

13W

1 Location of well:	County PRATT	Township name 54 9 W SW	Fraction	Section number 3	Town number 27	Range number 13
Distance and direction from nearest town or city: Street address of well location if in city: SUMNER + ADAMS ST IUKA KS				3 Owner of well: MARSHALL SWANDER Address: 823 S PINE PRATT		
Locate with "X" in section below: N W E S 1 Mile				Sketch map: 		
2 Type and color of material				From	To	
Soil				0	3	
CLAY				3	69	
MED SAND				69	80	
CLAY				80	88	
MED-COARSE SAND				88	100	
Clay				100	101	
(use a second sheet if needed)						
16 Remarks: elevation 4X4 SLAB TO BE DONE BY CUSTOMER				17 Water well contractor's certification: This well was drilled under my jurisdiction and this report is true to the best of my knowledge and belief. LYMAN BRIS 140 Business name MLD License No. Address MLD Signed W. W. Lyman Date 6-30-79 Authorized representative		

4 Well depth: 102 ft. Date of completion 6-26-76 Well diameter 4 in.
5 <input type="checkbox"/> Cable tool <input checked="" type="checkbox"/> Rotary <input type="checkbox"/> Driven <input type="checkbox"/> Dug <input type="checkbox"/> Hollow rod <input type="checkbox"/> Jetted <input type="checkbox"/> Bored <input type="checkbox"/> Reverse rotary
6 Use: <input checked="" type="checkbox"/> Domestic <input type="checkbox"/> Public supply <input type="checkbox"/> Industry <input type="checkbox"/> Irrigation <input type="checkbox"/> Air conditioning <input type="checkbox"/> Commercial <input type="checkbox"/> Test well
7 Casing: Material PVC Night: above/below Threaded <input type="checkbox"/> Welded <input checked="" type="checkbox"/> Surface 1 1/2 in. NA Diam. Weight 146 lbs./ft. 4 in. to 102 ft. depth Drive shoe? <input type="checkbox"/> Yes <input checked="" type="checkbox"/> No — in. to — ft. depth!
8 Screen: Manufacturer Peerless Type PVC Dia. 4" Slot/gauze 635 Length 10' Set between 92 ft. and 102 ft. Fittings: Gravel pack <input checked="" type="checkbox"/> Yes <input type="checkbox"/> No Size range of material 1/2 DN
9 Static water level: 65 ft. below land surface Date 6-4-76
10 Pumping level below land surfaces: — ft. after — hrs. pumping — g.p.m. — ft. after — hrs. pumping — g.p.m. Estimated maximum yield 50 g.p.m.
11 Water sample submitted: <input type="checkbox"/> Yes <input checked="" type="checkbox"/> No Date
<input checked="" type="checkbox"/> Well head completion: <input checked="" type="checkbox"/> Pitless adapter 14 inches above grade
<input checked="" type="checkbox"/> Well grouted? <input checked="" type="checkbox"/> Yes <input type="checkbox"/> No <input checked="" type="checkbox"/> Neat cement <input type="checkbox"/> Bentonite Depth: From 5 ft. to 12 ft.
14 Nearest source of possible contamination: ft. — Direction NONE Type — Well disinfected upon completion? <input checked="" type="checkbox"/> Yes <input type="checkbox"/> No
15 Pump: <input type="checkbox"/> Not installed Manufacturer's name Wells 221 Model number 234C HP 1/2 Volts 230 Length of drop pipe 94 ft. capacity 20 g.m.p. Type: <input checked="" type="checkbox"/> Submersible <input type="checkbox"/> Turbine <input type="checkbox"/> Jet <input type="checkbox"/> Reciprocating <input type="checkbox"/> Centrifugal <input type="checkbox"/> Other

Forward the white, blue and pink copies to the Kansas State Dept. Of Health.

Form WWC-5