USE TYPEWRITER OR BALL POINT PEN-PRESS FIRMLY, PRINT CLEARLY.

WATER WELL RECORD
KSA 82a-1201-1215

Kansas Department of Health and Environment-Division of Environment
(Water well Contractors)
Topeka, Kansas 66620

1. Location of well:	County	Fraction	Section number	Township number	Range number
	Pratt	NE 1/4 NE 1/4 SE 1/4	4	T 27S S	R 13W E/W

2. Distance and direction from nearest town or city: West edge of Iuka, Ks
Street address of well location if in city:

3. Owner of well: Don Klimen
R.R. or street:
City, state, zip code: Iuka, Kansas

4. Locate with "X" in section below:

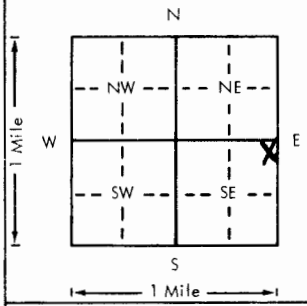

Sketch map:

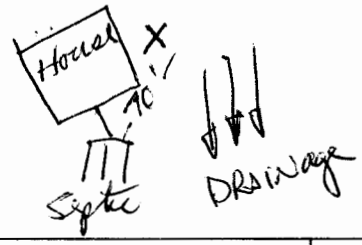

6. Bore hole dia. 10 in. Completion date
Well depth 85 ft. 19 Aug 77

7. __ Cable tool X Rotary __ Driven __ Dug
__ Hollow rod __ Jetted __ Bored __ Reverse rotary

8. Use: X Domestic __ Public supply __ Industry
__ Irrigation __ Air conditioning __ Stock
__ Lawn __ Oil field water __ Other

9. Casing: Material
Threaded __ Welded __
RMP X PVC
Dia. 5 in. to 65 ft. depth
Dia. __ in. to __ ft. depth
Height Above or below Surface 12 in.
Weight lbs./ft.
Wall Thickness: inches or gage No. 200

5. Type and color of material	From	To
Soil	0	2
Clay, brown	2	15
Clay, sandy brown	15	59
Sand, fine to coarse and med. gravel	59	85
Clay, white	85	110
Clay, blue sandy	110	118
Sand, fine to med. silty	118	141
Sand, fine to coarse and med. gravel, loose	141	144
Clay, white	144	150

(Use a second sheet if needed)

10. Screen: Manufacturer's name J&L
Type Saw Slot Dia. 5
Slot/gauze 18 Length 20'
Set between 65 ft. and 85 ft.
ft. and ft.
Gravel pack? X Size range of material 1/8 x 1/4

11. Static water level: mo./day/yr.
52 ft. below land surface Date 19 Aug 77

12. Pumping level below land surfaces:
ft. after hrs. pumping g.p.m.
ft. after hrs. pumping g.p.m.
Estimated maximum yield 50 g.p.m.

13. Water sample submitted: mo./day/yr.
__ Yes X No Date

14. Well head completion:
X Pitless adapter 12 Inches above grade

15. Well grouted? X
With: X Neat cement __ Bentonite __ Concrete
Depth: From 4 ft. to 14 ft.

16. Nearest source of possible contamination:
ft. 70 Direction SW Type Septic
Well disinfected upon completion? X Yes __ No

17. Pump: __ Not installed
Manufacturer's name STA RITE
Model number Sea 20 HP 3/4 Volts 230
Length of drop pipe 70 ft. capacity 15 g.p.m.
Type:
X Submersible __ Turbine
__ Jet __ Reciprocating
__ Centrifugal __ Other

18. Elevation:

Topography:
__ Hill
__ Slope
X Upland
__ Valley

19. Remarks: 4'X4'X4" Slab below pit Adapt

20. Water well contractor's certification:
This well was drilled under my jurisdiction and this report is true to the best of my knowledge and belief.
Central Well & Pump 325
Business name License No.
Address 121 S Taylor Pratt
Signed [signature] Authorized representative Date 20 July 78

T 27 R 13 W Sec 4 NE 1/4 NE 1/4 SE 1/4

Forward the white, blue and pink copies to the Department of Health and Environment

Form WWC-5

MI-1023