


COLLECTED REPORT

WATER WELL RECORD Form WWC-5 KSA 82a-1212

1 LOCATION OF WATER WELL:	Fraction	Section Number	Township Number	Range Number
County: Pratt	SE 1/4 NW 1/4 NW 1/4	7	T 27 S	R 13 EW

Distance and direction from nearest town or city street address of well if located within city?
4 N 2 3/4 W 1/4 S of Pratt, Kansas

2 WATER WELL OWNER: Ed Petrosky	Board of Agriculture, Division of Water Resources
RR#, St. Address, Box #: Iuka, Kansas	Application Number:
City, State, ZIP Code:	

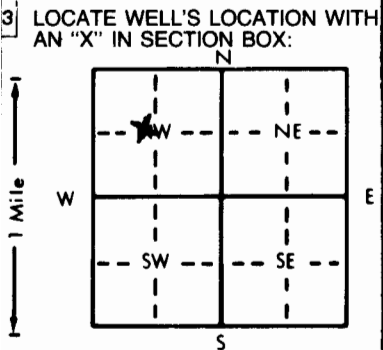

4 DEPTH OF COMPLETED WELL: 212 ft. ELEVATION:	Depth(s) Groundwater Encountered 1. 56 ft. 2. ft. 3. ft.
WELL'S STATIC WATER LEVEL: 55.5 ft. below land surface measured on mo/day/yr Aug. 13 1980	Pump test data: Well water was 70.5 ft. after 1 hours pumping 800 gpm
Est. Yield: 1300 gpm: Well water was 75.5 ft. after 1 hours pumping 1000 gpm	Bore Hole Diameter: . in. to . ft., and . in. to . ft.
WELL WATER TO BE USED AS:	5 Public water supply 8 Air conditioning 11 Injection well
1 Domestic 3 Feedlot 6 Oil field water supply 9 Dewatering 12 Other (Specify below)	2 Irrigation 4 Industrial 7 Lawn and garden only 10 Observation well
Was a chemical/bacteriological sample submitted to Department? Yes.....No..... X; If yes, mo/day/yr sample was submitted	Water Well Disinfected? Yes X No

5 TYPE OF BLANK CASING USED:	5 Wrought iron 8 Concrete tile	CASING JOINTS: Glued.....Clamped.....
1 Steel 3 RMP (SR)	6 Asbestos-Cement 9 Other (specify below)	Welded X
2 PVC 4 ABS	7 Fiberglass	Threaded.....
Blank casing diameter: 16 in. to 72 in. Dia. ft., Dia. in. to ft.	Casing height above land surface: 12 in., weight 32.7 lbs./ft. Wall thickness or gauge No. 188	
TYPE OF SCREEN OR PERFORATION MATERIAL:	7 PVC 10 Asbestos-cement	
1 Steel 3 Stainless steel 5 Fiberglass 8 RMP (SR) 11 Other (specify)	2 Brass 4 Galvanized steel 6 Concrete tile 9 ABS 12 None used (open hole)	
SCREEN OR PERFORATION OPENINGS ARE:	5 Gauzed wrapped 8 Saw cut 11 None (open hole)	
1 Continuous slot 3 Mill slot 6 Wire wrapped 9 Drilled holes	2 Louvered shutter 4 Key punched 7 Torch cut 10 Other (specify)	
SCREEN-PERFORATED INTERVALS: From 72 ft. to 82 Hori. Brown ft., From 92 ft. to 116 Doerr ft.	From 116 ft. to 126 Hori. Brown ft., From 126 ft. to 138 Doerr ft.	
GRAVEL PACK INTERVALS: From 176 ft. to 212 Doerr ft., From ft. to ft.	From 10 ft. to 212 ft., From ft. to ft.	

6 GROUT MATERIAL:	1 Neat cement 2 Cement grout 3 Bentonite 4 Other	Grout Intervals: From 0 ft. to 10 ft., From ft. to ft., From ft. to ft.
What is the nearest source of possible contamination:	1 Septic tank 4 Lateral lines 7 Pit privy 10 Livestock pens 14 Abandoned water well	2 Sewer lines 5 Cess pool 8 Sewage lagoon 11 Fuel storage 15 Oil well/Gas well
3 Watertight sewer lines 6 Seepage pit 9 Feedyard 12 Fertilizer storage 16 Other (specify below)	13 Insecticide storage none	
Direction from well?	How many feet?	

FROM	TO	LITHOLOGIC LOG	FROM	TO	LITHOLOGIC LOG
0	2	Top soil			
2	31	Clay, tan and brown			
31	40	Sand, fine to coarse			
40	56	Clay, tan and sandy			
56	82	Sand, fine to coarse and med gravel, loose			
82	98	Clay, tan and white			
98	103	Sand, fine to coarse and fine gravel			
103	112	Clay, tan and sandy			
112	138	Sand, fine to coarse and med gravel, loose			
138	162	Clay, blue			
162	168	Sand, very fine to coarse			
168	178	Clay, red and gray			
178	200	Sand, fine and fine gravel			

7 CONTRACTOR'S OR LANDOWNER'S CERTIFICATION: This water well was re constructed, (2) reconstructed, or (3) plugged under my jurisdiction and was completed on (mo/day/year) Sept. 10 1980 and this record is true to the best of my knowledge and belief. Kansas Water Well Contractor's License No. 325 This Water Well Record was completed on (mo/day/yr) June 29 81 under the business name of Central Well & Pump Inc. by (signature) <i>[Signature]</i>	
--	--

INSTRUCTIONS: Use typewriter or ball point pen, PLEASE PRESS FIRMLY and PRINT clearly. Please fill in blanks, underline or circle the correct answers. Send top three copies to Kansas Department of Health and Environment, Division of Environment, Environmental Geology Section, Topeka, KS 66620. Send one to WATER WELL OWNER and retain one for your records.

OFFICE USE ONLY
T
27
R
13
EW
SEC.
7
SE 1/4
NW 1/4
NW 1/4

D