

Scott #1-A


1 LOCATION OF WATER WELL: County: <u>Pratt</u>	Fraction <u>NW</u> 1/4 <u>NE</u> 1/4 <u>NW</u> 1/4	Section Number <u>18</u>	Township Number T <u>27</u> S	Range Number R <u>13</u> E <u>(W)</u>
---	---	-----------------------------	----------------------------------	--

Distance and direction from nearest town or city street address of well if located within city?
4 mile North + 2 3/4 mile West of Pratt, Kansas

2 WATER WELL OWNER: Maysel Scott
 RR#, St. Address, Box #: 917 Lorimer St
 City, State, ZIP Code: Pratt, Kansas

Board of Agriculture, Division of Water Resources
 Application Number: T84-436

3 LOCATE WELL'S LOCATION WITH AN "X" IN SECTION BOX:

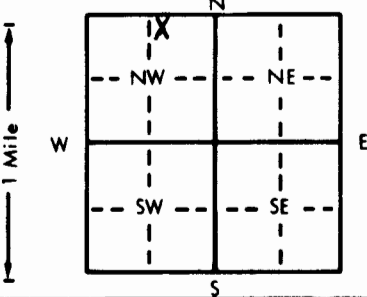

4 DEPTH OF COMPLETED WELL: 82 ft. ELEVATION: NA

Depth(s) Groundwater Encountered 1. ft. 2. ft. 3. ft.

WELL'S STATIC WATER LEVEL 59 ft. below land surface measured on mo/day/yr 7-24-84

Pump test data: Well water was ft. after hours pumping gpm

Est. Yield gpm: Well water was ft. after hours pumping gpm

Bore Hole Diameter in. to ft., and in. to ft.

WELL WATER TO BE USED AS:

1 Domestic <u>WAS</u>	2 Irrigation	3 Feedlot	4 Industrial	5 Public water supply	6 Oil field water supply	7 Lawn and garden only	8 Air conditioning	9 Dewatering	10 Observation well	11 Injection well	12 Other (Specify below)
-----------------------	--------------	-----------	--------------	-----------------------	--------------------------	------------------------	--------------------	--------------	---------------------	-------------------	--------------------------

Was a chemical/bacteriological sample submitted to Department? Yes.....No.....; If yes, mo/day/yr sample was submitted

Water Well Disinfected? Yes No

5 TYPE OF BLANK CASING USED:

1 Steel	2 PVC	3 RMP (SR)	4 ABS	5 Wrought iron	6 Asbestos-Cement	7 Fiberglass	8 Concrete tile	9 Other (specify below)	CASING JOINTS: Glued Clamped
---------	-------	------------	-------	----------------	-------------------	--------------	-----------------	-------------------------	--

Blank casing diameter 5 in. to 67 ft., Dia. in. to ft., Dia. in. to ft.

Casing height above land surface 3 ft. below in., weight lbs./ft. Wall thickness or gauge No.

TYPE OF SCREEN OR PERFORATION MATERIAL:

1 Steel	2 Brass	3 Stainless steel	4 Galvanized steel	5 Fiberglass	6 Concrete tile	7 PVC	8 RMP (SR)	9 ABS	10 Asbestos-cement	11 Other (specify)	12 None used (open hole)
---------	---------	-------------------	--------------------	--------------	-----------------	-------	------------	-------	--------------------	--------------------------	--------------------------

SCREEN OR PERFORATION OPENINGS ARE:

1 Continuous slot	2 Louvered shutter	3 Mill slot	4 Key punched	5 Gauzed wrapped	6 Wire wrapped	7 Torch cut	8 Saw cut	9 Drilled holes	10 Other (specify)	11 None (open hole)
-------------------	--------------------	-------------	---------------	------------------	----------------	-------------	-----------	-----------------	--------------------------	---------------------

SCREEN-PERFORATED INTERVALS: From 67 ft. to 82 ft., From ft. to ft.

GRAVEL PACK INTERVALS: From ft. to ft., From ft. to ft.

6 GROUT MATERIAL: 1 Neat cement 2 Cement grout 3 Bentonite 4 Other

Grout Intervals: From ft. to ft., From ft. to ft., From ft. to ft.

What is the nearest source of possible contamination:

1 Septic tank	2 Sewer lines	3 Watertight sewer lines	4 Lateral lines	5 Cess pool	6 Seepage pit	7 Pit privy	8 Sewage lagoon	9 Feedyard	10 Livestock pens	11 Fuel storage	12 Fertilizer storage	13 Insecticide storage	14 Abandoned water well	15 Oil well/Gas well	16 Other (specify below)
---------------	---------------	--------------------------	-----------------	-------------	---------------	-------------	-----------------	------------	-------------------	-----------------	-----------------------	------------------------	-------------------------	----------------------	--------------------------

Direction from well? How many feet?

FROM	TO	LITHOLOGIC LOG	FROM	TO	LITHOLOGIC LOG
<u>82</u>	<u>59</u>	<u>Sand & Gravel fill (3.07 Cu. ft.)</u>			
<u>59</u>	<u>3</u>	<u>Cement Grout (7.08 Cu. ft.)</u>			
		<u>Casing cut off 3' below G.L. and removed</u>			
		<u>Plugged well covered with surface soil to G.L.</u>			

7 CONTRACTOR'S OR LANDOWNER'S CERTIFICATION: This water well was (1) constructed, (2) reconstructed, or (3) plugged under my jurisdiction and was completed on (mo/day/year) 8-2-1984 and this record is true to the best of my knowledge and belief. Kansas Water Well Contractor's License No. NA This Water Well Record was completed on (mo/day/yr) 8-6-1984 under the business name of Heartland Dig. Inc. by (signature) Jack L. Kow

INSTRUCTIONS: Use typewriter or ball point pen, PLEASE PRESS FIRMLY and PRINT clearly. Please fill in blanks, underline or circle the correct answers. Send top three copies to Kansas Department of Health and Environment, Division of Environment, Environmental Geology Section, Topeka, KS 66620. Send one to WATER WELL OWNER and retain one for your records.

OFFICE USE ONLY
T
R
EW
SEC.
1/4
1/4
1/4