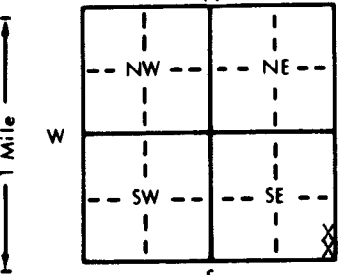


1 LOCATION OF WATER WELL: Fraction SE 1/4 SE 1/4 SE 1/4 Section Number 21 Township Number T 27 S Range Number R 13 EW  
 County: PRATT

Distance and direction from nearest town or city street address of well if located within city?  
1-N OF PRATT, KS.

2 WATER WELL OWNER: CLIFF KELLER  
 RR#, St. Address, Box #: BOX 442 Board of Agriculture, Division of Water Resources  
 City, State, ZIP Code: PRATT, KS. 67124 Application Number:

3 LOCATE WELL'S LOCATION WITH AN "X" IN SECTION BOX:  
  
 4 DEPTH OF COMPLETED WELL: 121 ft. ELEVATION:  
 Depth(s) Groundwater Encountered 1. .... ft. 2. .... ft. 3. .... ft.  
 WELL'S STATIC WATER LEVEL 73 ft. below land surface measured on mo/day/yr  
 Pump test data: Well water was .... ft. after .... hours pumping .... gpm  
 Est. Yield .... gpm: Well water was .... ft. after .... hours pumping .... gpm  
 Bore Hole Diameter: 9 in. to .... ft., and .... in. to .... ft.  
 WELL WATER TO BE USED AS: 5 Public water supply 8 Air conditioning 11 Injection well  
 XXX Domestic 3 Feedlot 6 Oil field water supply 9 Dewatering 12 Other (Specify below)  
 2 Irrigation 4 Industrial 7 Lawn and garden only 10 Monitoring well  
 Was a chemical/bacteriological sample submitted to Department? Yes.....No. X; If yes, mo/day/yr sample was submitted  
 Water Well Disinfected? Yes X No

5 TYPE OF BLANK CASING USED: 5 Wrought iron 8 Concrete tile CASING JOINTS: Glued X Clamped  
 1 Steel 3 RMP (SR) 6 Asbestos-Cement 9 Other (specify below) Welded  
XX PVC 4 ABS 7 Fiberglass Threaded  
 Blank casing diameter 5 in. to 101 ft., Dia. .... in. to .... ft., Dia. .... in. to .... ft.  
 Casing height above land surface 12 in., weight .... lbs./ft. Wall thickness or gauge No.  
 TYPE OF SCREEN OR PERFORATION MATERIAL: XX PVC 10 Asbestos-cement  
 1 Steel 3 Stainless steel 5 Fiberglass 8 RMP (SR) 11 Other (specify)  
 2 Brass 4 Galvanized steel 6 Concrete tile 9 ABS 12 None used (open hole)  
 SCREEN OR PERFORATION OPENINGS ARE: 5 Gauzed wrapped 8 Saw cut 11 None (open hole)  
 1 Continuous slot X Mill slot 6 Wire wrapped 9 Drilled holes  
 2 Louvered shutter 4 Key punched 7 Torch cut 10 Other (specify)  
 SCREEN-PERFORATED INTERVALS: From 101 ft. to 121 ft., From .... ft. to .... ft.  
 From .... ft. to .... ft., From .... ft. to .... ft.  
 GRAVEL PACK INTERVALS: From 23 ft. to 121 ft., From .... ft. to .... ft.  
 From .... ft. to .... ft., From .... ft. to .... ft.

6 GROUT MATERIAL: 1 Neat cement 2 Cement grout XX3 Bentonite 4 Other  
 Grout intervals: From 0 ft. to 23 ft., From .... ft. to .... ft., From .... ft. to .... ft.  
 What is the nearest source of possible contamination:  
 1 Septic tank 4 Lateral lines 7 Pit privy 10 Livestock pens 14 Abandoned water well  
 2 Sewer lines 5 Cess pool 8 Sewage lagoon 11 Fuel storage 15 Oil well/Gas well  
 3 Watertight sewer lines 6 Seepage pit 9 Feedyard 12 Fertilizer storage 16 Other (specify below)  
 13 Insecticide storage NONE

FROM	TO	LITHOLOGIC LOG	FROM	TO	PLUGGING INTERVALS
0	3	TOP SOIL			
3	75	CLAY			
75	96	GRAVEL			
96	105	CLAY			
105	121	GRAVEL			

7 CONTRACTOR'S OR LANDOWNER'S CERTIFICATION: This water well was XX (1) constructed, (2) reconstructed, or (3) plugged under my jurisdiction and was completed on (mo/day/year) 1-22-92 and this record is true to the best of my knowledge and belief. Kansas Water Well Contractor's License No. 462-B This Water Well Record was completed on (mo/day/yr) 6-3-92 under the business name of SAM'S WATER WELL SERVICE by (signature) [Signature]

OFFICE USE ONLY T R EW SEC. 1/4 1/4 1/4