


1 LOCATION OF WATER WELL: County: Pratt Fraction: $\frac{1}{4}$ NE $\frac{1}{4}$ ~~SW~~ SE $\frac{1}{4}$ Section Number: 34 Township Number: T 27 S Range Number: R 13 E/W

Distance and direction from nearest town or city street address of well if located within city?

502 Sunrise, Pratt KS

2 WATER WELL OWNER: John Neumann
 RR#, St. Address, Box # : 502 Sunrise Board of Agriculture, Division of Water Resources
 City, State, ZIP Code : Pratt, KS 67124 Application Number: not required

3 LOCATE WELL'S LOCATION WITH AN "X" IN SECTION BOX: 4 DEPTH OF COMPLETED WELL... 82... ft. ELEVATION: unknown

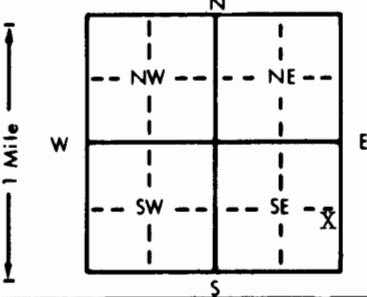

Depth(s) Groundwater Encountered 1. 22... ft. 2. ft. 3. ft.
 WELL'S STATIC WATER LEVEL 22... ft. below land surface measured on mo/day/yr 7/2/85.....
 Pump test data: Well water was not ck'd... ft. after hours pumping gpm
 Est. Yield unknown gpm: Well water was ft. after hours pumping gpm
 Bore Hole Diameter... 9... in. to 82... ft., and in. to ft.
 WELL WATER TO BE USED AS: 5 Public water supply 8 Air conditioning 11 Injection well
 1 Domestic 3 Feedlot 6 Oil field water supply 9 Dewatering 12 Other (Specify below)
 2 Irrigation 4 Industrial 7 Lawn and garden only 10 Observation well
 Was a chemical/bacteriological sample submitted to Department? Yes.....No.....X.....; If yes, mo/day/yr sample was submitted
 Water Well Disinfected? Yes X No

5 TYPE OF CASING USED: 5 Wrought iron 8 Concrete tile CASING JOINTS: Glued X Clamped
 1 Steel 3 RMP (SR) 6 Asbestos-Cement 9 Other (specify below) Welded
 2 PVC 4 ABS 7 Fiberglass Threaded
 Blank casing diameter 5... in. to 65... ft., Dia in. to ft., Dia in. to ft.
 Casing height above land surface 24... in., weight 2.277... lbs./ft. Wall thickness or gauge No. 214

TYPE OF SCREEN OR PERFORATION MATERIAL: 7 PVC 10 Asbestos-cement
 1 Steel 3 Stainless steel 5 Fiberglass 8 RMP (SR) 11 Other (specify)
 2 Brass 4 Galvanized steel 6 Concrete tile 9 ABS 12 None used (open hole)

SCREEN OR PERFORATION OPENINGS ARE: 5 Gauzed wrapped 8 Saw cut 11 None (open hole)
 1 Continuous slot 3 Mill slot 6 Wire wrapped 9 Drilled holes
 2 Louvered shutter 4 Key punched 7 Torch cut 10 Other (specify)

SCREEN-PERFORATED INTERVALS: From 65... ft. to 80... ft., From ft. to ft.
 From ft. to ft., From ft. to ft.
 GRAVEL PACK INTERVALS: From 40... ft. to 80... ft., From ft. to ft.
Annular Fill From 10... ft. to 36... ft., From ft. to ft.

6 GROUT MATERIAL: 1 Neat cement 2 Cement grout 3 Bentonite 4 Other
 Grout Intervals: From 0... ft. to 10... ft., From 36... ft. to 40... ft., From ft. to ft.

What is the nearest source of possible contamination:
 1 Septic tank 4 Lateral lines 7 Pit privy 10 Livestock pens 14 Abandoned water well
 2 Sewer lines 5 Cess pool 8 Sewage lagoon 11 Fuel storage 15 Oil well/Gas well
 3 Watertight sewer lines 6 Seepage pit 9 Feedyard 12 Fertilizer storage 16 Other (specify below)
 13 Insecticide storage
 Direction from well? all How many feet? over 50'

FROM	TO	LITHOLOGIC LOG	FROM	TO	LITHOLOGIC LOG
0	6	Topsoil & clay			
6	13	Sand & gravel, med. to coarse			
13	22	Soft tan clay			
22	45	Sand & gravel, fine to very fine			
45	58	Sand & gravel, med. to fine to coarse			
58	65	Soft tan sandy clay			
65	80	Sand & gravel, fine, some med.			
80		Clay - tan			

7 CONTRACTOR'S OR LANDOWNER'S CERTIFICATION: This water well was (1) constructed, (2) reconstructed, or (3) plugged under my jurisdiction and was completed on (mo/day/year) 7/2/85 and this record is true to the best of my knowledge and belief. Kansas Water Well Contractor's License No. 185 This Water Well Record was completed on (mo/day/yr) 7/23/85 under the business name of Clarke Well & Eq., Inc. by (signature) *[Signature]*

INSTRUCTIONS: Use typewriter or ball point pen, PLEASE PRESS FIRMLY and PRINT clearly. Please fill in blanks, underline or circle the correct answers. Send top three copies to Kansas Department of Health and Environment, Division of Environment, Environmental Geology Section, Topeka, KS 66620. Send one to WATER WELL OWNER and retain one for your records.

OFFICE USE ONLY
T
R
EW
SEC.