WATER WELL RECORD Form WWC-5 KSA 82a-1212

1 LOCATION OF WATER WELL: County: Pratt	Fraction: SE ¼ SW ¼ SW ¼	Section Number: 34	Township Number: T 27 S	Range Number: R 13 E(W)

Distance and direction from nearest town or city street address of well if located within city?
123 N. Pine Pratt, Ks.

2 WATER WELL OWNER: Lester Beck
RR#, St. Address, Box # : 123 N. Pine
City, State, ZIP Code : Pratt, Ks. 67124
Board of Agriculture, Division of Water Resources Application Number:

3 LOCATE WELL'S LOCATION WITH AN "X" IN SECTION BOX:

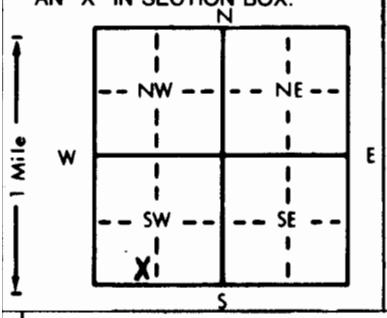

4 DEPTH OF COMPLETED WELL 80 ft. ELEVATION:
Depth(s) Groundwater Encountered 1. 45 ft. 2. ft. 3. ft.
WELL'S STATIC WATER LEVEL 45 ft. below land surface measured on mo/day/yr 2 Aug. 85
Pump test data: Well water was ft. after hours pumping gpm
Est. Yield 80 gpm: Well water was ft. after hours pumping gpm
Bore Hole Diameter 10 in. to 80 ft., and in. to ft.
WELL WATER TO BE USED AS: 5 Public water supply 8 Air conditioning 11 Injection well
1 Domestic 3 Feedlot 6 Oil field water supply 9 Dewatering 12 Other (Specify below)
2 Irrigation 4 Industrial XX Lawn and garden only X 10 Observation well
Was a chemical/bacteriological sample submitted to Department? Yes No X; If yes, mo/day/yr sample was submitted
Water Well Disinfected? Yes X No

5 TYPE OF BLANK CASING USED: 5 Wrought iron 8 Concrete tile CASING JOINTS: Glued X Clamped
1 Steel 3 RMP (SR) 6 Asbestos-Cement 9 Other (specify below) Welded
XX PVC XX 4 ABS 7 Fiberglass Threaded
Blank casing diameter 5 in. to 60 ft., Dia in. to ft., Dia in. to ft.
Casing height above land surface 12 in., weight 2.34 lbs./ft. Wall thickness or gauge No. .214
TYPE OF SCREEN OR PERFORATION MATERIAL: XX PVC XX 10 Asbestos-cement
1 Steel 3 Stainless steel 5 Fiberglass 8 RMP (SR) 11 Other (specify)
2 Brass 4 Galvanized steel 6 Concrete tile 9 ABS 12 None used (open hole)
SCREEN OR PERFORATION OPENINGS ARE: 5 Gauzed wrapped X Saw cut X 11 None (open hole)
1 Continuous slot 3 Mill slot 6 Wire wrapped 9 Drilled holes
2 Louvered shutter 4 Key punched 7 Torch cut 10 Other (specify)
SCREEN-PERFORATED INTERVALS: From 60 ft. to 80 ft., From ft. to ft.
From ft. to ft., From ft. to ft.
GRAVEL PACK INTERVALS: From 14 ft. to 80 ft., From ft. to ft.
From ft. to ft., From ft. to ft.

6 GROUT MATERIAL: 1 Neat cement X Cement grout X 3 Bentonite 4 Other
Grout Intervals: From ft. to 4 ft., From 14 ft. to ft., From ft. to ft.
What is the nearest source of possible contamination: 10 Livestock pens 14 Abandoned water well
Septic tank 4 Lateral lines 7 Pit privy 11 Fuel storage 15 Oil well/Gas well
XX Sewer lines XX 5 Cess pool 8 Sewage lagoon 12 Fertilizer storage 16 Other (specify below)
3 Watertight sewer lines 6 Seepage pit 9 Feedyard 13 Insecticide storage Water tight sewer
Direction from well? How many feet? lines 55' West of well

FROM	TO	LITHOLOGIC LOG	FROM	TO	LITHOLOGIC LOG
0	2	Soil,top			
2	16	Clay,tan			
16	33	Sand,fine to coarse and fine gravel			
33	40	Clay,tan			
40	80	Sand, fine to coarse and fine to coarse gravel			

7 CONTRACTOR'S OR LANDOWNER'S CERTIFICATION: This water well was (1) constructed, (2) reconstructed, or (3) plugged under my jurisdiction and was completed on (mo/day/year) 2 Aug. 85 and this record is true to the best of my knowledge and belief. Kansas Water Well Contractor's License No. 325 This Water Well Record was completed on (mo/day/yr) 22 Aug. 85 under the business name of Centeral Well & Pump Inc. by (signature) [signature]

INSTRUCTIONS: Use typewriter or ball point pen, *PLEASE PRESS FIRMLY* and *PRINT* clearly. Please fill in blanks, underline or circle the correct answers. Send top three copies to Kansas Department of Health and Environment, Division of Environment, Environmental Geology Section, Topeka, KS 66620. Send one to WATER WELL OWNER and retain one for your records.

OFFICE USE ONLY T R E/W SEC. ¼ ¼ ¼