


1 LOCATION OF WATER WELL: County: Pratt Fraction: SE 1/4 SE 1/4 SE 1/4 Section Number: 34 Township Number: T 27 S Range Number: R 13 E

Distance and direction from nearest town or city street address of well if located within city? 1412 E. 1st Pratt KS MW-4

2 WATER WELL OWNER: The Musket Corporation RR#, St. Address, Box #: P.O. Box 26210 City, State, ZIP Code: Oklahoma City, OK 73126 Board of Agriculture, Division of Water Resources Application Number:

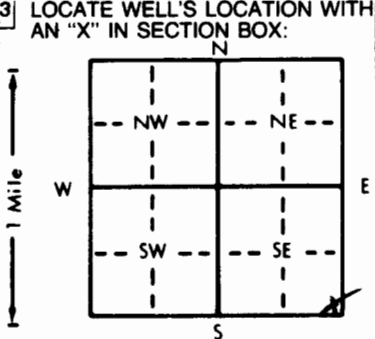

4 DEPTH OF COMPLETED WELL: 30 ft. ELEVATION: 27.2 ft. Depth(s) Groundwater Encountered: 1. 27.2 ft. 2. 27.80 ft. 3. 3/26/90 ft. WELL'S STATIC WATER LEVEL: 27.80 ft. below land surface measured on mo/day/yr 3/26/90 Pump test data: Well water was 7 gpm after 30 hours pumping 7 gpm Est. Yield: Well water was 7 gpm after 30 hours pumping 7 gpm Bore Hole Diameter: 7 in. to 30 ft., and 30 in. to 30 ft. WELL WATER TO BE USED AS: 5 Public water supply 8 Air conditioning 11 Injection well 1 Domestic 3 Feedlot 6 Oil field water supply 9 Dewatering 12 Other (Specify below) 2 Irrigation 4 Industrial 7 Lawn and garden only 10 Monitoring well Was a chemical/bacteriological sample submitted to Department? Yes X No X; If yes, mo/day/yr sample was submitted Water Well Disinfected? Yes X No X

5 TYPE OF BLANK CASING USED: 1 Steel 2 PVC 3 RMP (SR) 4 ABS 5 Wrought iron 6 Asbestos-Cement 7 Fiberglass 8 Concrete tile 9 Other (specify below) CASING JOINTS: Glued X Clamped X Welded X Threaded X Blank casing diameter: 2.0 in. to 20 ft., Dia. 0.7 in. to 40 ft., Dia. Casing height above land surface: 0 in., weight 0.7 lbs./ft. Wall thickness or gauge No. 40 TYPE OF SCREEN OR PERFORATION MATERIAL: 1 Steel 2 Brass 3 Stainless steel 4 Galvanized steel 5 Fiberglass 6 Concrete tile 7 RMP (SR) 8 ABS 9 Other (specify below) 10 Asbestos-cement 11 Other (specify below) 12 None used (open hole) SCREEN OR PERFORATION OPENINGS ARE: 1 Continuous slot 2 Louvered shutter 3 8 Mill slot 4 Key punched 5 Gauzed wrapped 6 Wire wrapped 7 Torch cut 8 Saw cut 9 Drilled holes 10 Other (specify below) 11 None (open hole) SCREEN-PERFORATED INTERVALS: From 20 ft. to 30 ft. GRAVEL PACK INTERVALS: From 18 ft. to 30 ft.

6 GROUT MATERIAL: 1 Neat cement 2 Cement grout 3 Bentonite 4 Other Grout intervals: From 0 ft. to 15 ft., From 15 ft. to 18 ft., From 18 ft. to 30 ft. What is the nearest source of possible contamination: 1 Septic tank 2 Sewer lines 3 Watertight sewer lines 4 Lateral lines 5 Cess pool 6 Seepage pit 7 Pit privy 8 Sewage lagoon 9 Feedyard 10 Livestock pens 11 Fuel storage 12 Fertilizer storage 13 Insecticide storage 14 Abandoned water well 15 Oil well/Gas well 16 Other (specify below) Direction from well? Northwest How many feet? 100

FROM	TO	LITHOLOGIC LOG	FROM	TO	PLUGGING INTERVALS
<u>0</u>	<u>16</u>	<u>Light Brown, SANDY CLAY</u>			
<u>16</u>	<u>22</u>	<u>Light R. Brown, CLAYEY/SILTY SAND</u>			
<u>22</u>	<u>30</u>	<u>Light Brown, SAND</u>			

7 CONTRACTOR'S OR LANDOWNER'S CERTIFICATION: This water well was (1) constructed, (2) reconstructed, or (3) plugged under my jurisdiction and was completed on (mo/day/year) 3/20/90 and this record is true to the best of my knowledge and belief. 

OFFICE USE ONLY
T
R
EW
SEC.