


Distance and direction from nearest town or city street address of well if located within city?

730 East 1st. Pratt

2	WATER WELL OWNER:	Phillip Eubanks	
	RR#, St. Address, Box # :	603 N. Pine	Board of Agriculture, Division of Water Resources
	City, State, ZIP Code :	Pratt, Ks. 67124	Application Number:

3 LOCATE WELL'S LOCATION WITH AN "X" IN SECTION BOX:

DEPTH OF COMPLETED WELL.....45.5.....ft. ELEVATION:

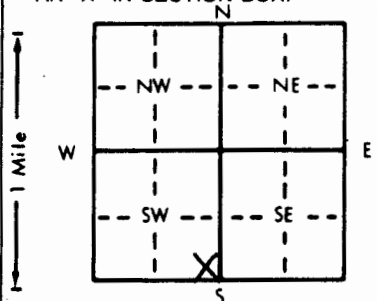

Depth(s) Groundwater Encountered 1. . ft. 2. . ft. 3. . ft.

WELL'S STATIC WATER LEVEL . ft. below land surface measured on mo/day/yr

Pump test data: Well water was . ft. after . hours pumping . gpm

Est. Yield . gpm: Well water was . ft. after . hours pumping . gpm

Bore Hole Diameter, 7.5/8 in. to 45.5 ft., and . in. to . ft.

WELL WATER TO BE USED AS:

5 Public water supply	8 Air conditioning	11 Injection well
1 Domestic	3 Feedlot	6 Oil field water supply
2 Irrigation	4 Industrial	7 Lawn and garden only
		9 Dewatering
		12 Other (Specify below)
		10 Monitoring well

Was a chemical/bacteriological sample submitted to Department? Yes.....No X.....; If yes, mo/day/yr sample was submitted

Water Well Disinfected? Yes No X

5 TYPE OF PIPE CASING USED:		3 Wrought iron		8 Concrete tile		CASING JOINTS: Glued Clamped	
1 Steel		6 Asbestos-Cement		9 Other (specify below)		Welded	
2 PVC		7 Fiberglass				Threaded. <input checked="" type="checkbox"/>	
17 Blank casing diameter 2 in. to 40.5 ft., Dia in. to ft., Dia in. to ft.							
18 Casing height above land surface 0 in., weight lbs./ft. Wall thickness or gauge No. sch. 40							
TYPE OF SCREEN OR PERFORATION MATERIAL:							
1 Steel		3 Stainless steel		5 Fiberglass		7 PVC	
2 Brass		4 Galvanized steel		6 Concrete tile		8 RMP (SR)	
						10 Asbestos-cement	
						11 Other (specify)	
						12 None used (open hole)	
SCREEN OR PERFORATION OPENINGS ARE:							
1 Continuous slot		3 Mill slot		5 Gauzed wrapped		8 Saw cut	
2 Louvered shutter		4 Key punched		6 Wire wrapped		11 None (open hole)	
				7 Torch cut		9 Drilled holes	
						10 Other (specify)	
SCREEN-PERFORATED INTERVALS: From 40.5 ft. to 45.5 ft., From ft. to ft., From ft. to ft.							
GRAVEL PACK INTERVALS: From ft. to ft., From ft. to ft., From ft. to ft.							
From 40 ft. to 45.5 ft., From ft. to ft.							

6 GROUT MATERIAL: 1 Neat cement 2 Cement grout 3 Bentonite 4 Other
Grout Intervals: From 0 ft. to 38 ft. From 38 ft. to 40 ft. From ft. to ft.
What is the nearest source of possible contamination:
1 Septic tank 4 Lateral lines 7 Pit privy 10 Livestock pens 14 Abandoned water well
2 Sewer lines 5 Cess pool 8 Sewage lagoon 11 Fuel storage 15 Oil well/Gas well
3 Watertight sewer lines 6 Seepage pit 9 Feedyard 12 Fertilizer storage 16 Other (specify below)
13 Insecticide storage
Direction from well? NW How many feet? 70

FROM	TO	LITHOLOGIC LOG	FROM	TO	PLUGGING INTERVALS
0	6"	concrete			VEW-flush mount cover
6"	1'	fill sand			
1	7	cly, dk brn, slty			
7	15	snd, fine, clean			
5	17	cly, med brn			
17	19	cly, med brn, sndy			
19	20	snd, fine, clean			
20	40	cly, brn and gray			
40	45.5	snd, fine, clean			
					Carpet Station

7. CONTRACTOR'S OR LANDOWNER'S CERTIFICATION: This water well was (1) constructed, (2) reconstructed, or (3) plugged under my jurisdiction and was completed on (mo/day/year) 08-03-93 and this record is true to the best of my knowledge and belief. Kansas Water Well Contractor's License No. 527 This Water Well Record was completed on (mo/day/yr) 11-16-93 under the business name of GeoCore Services, Inc. by (signature) [Signature]