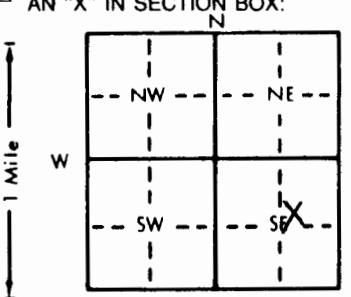


1 LOCATION OF WATER WELL: Fraction SW 1/4 NE 1/4 SE 1/4 Section Number 9 Township Number T 27 S Range Number R 13 E/W

Distance and direction from nearest town or city street address of well if located within city?
 650 feet west of Hwy 281 on 8th Str.

2 WATER WELL OWNER: Pratt Airport Authority
 RR#, St. Address, Box #: P.O. Box 807 Board of Agriculture, Division of Water Resources
 City, State, ZIP Code: Pratt, Kansas 67124 Application Number:

3 LOCATE WELL'S LOCATION WITH AN "X" IN SECTION BOX:

 4 DEPTH OF COMPLETED WELL: 85 ft. ELEVATION:
 Depth(s) Groundwater Encountered 1. ft. 2. ft. 3. ft.
 WELL'S STATIC WATER LEVEL 62.80 ft. below TOC measured on mo/day/yr 08-12-94
 Pump test data: Well water was . ft. after . hours pumping . gpm
 Est. Yield . gpm: Well water was . ft. after . hours pumping . gpm
 Bore Hole Diameter . in. to . ft., and . in. to . ft.
 WELL WATER TO BE USED AS: 5 Public water supply 8 Air conditioning 11 Injection well
 1 Domestic 3 Feedlot 6 Oil field water supply 9 Dewatering 12 Other (Specify below)
 2 Irrigation 4 Industrial 7 Lawn and garden only 10 Monitoring well
 Was a chemical/bacteriological sample submitted to Department? Yes . No . If yes, mo/day/yr sample was submitted
 Water Well Disinfected? Yes No

5 TYPE OF BLANK CASING USED:
 1 Steel 3 RMP (SR) 5 Wrought iron 8 Concrete tile CASING JOINTS: Glued . Clamped .
 2 PVC 4 ABS 6 Asbestos-Cement 9 Other (specify below) Welded .
 7 Fiberglass Threaded.
 Blank casing diameter . 2 . in. to . 65 . ft., Dia . in. to . ft., Dia . in. to . ft.
 Casing height above land surface . 30 . in., weight . lbs./ft. Wall thickness or gauge No. Sch. 40
 TYPE OF SCREEN OR PERFORATION MATERIAL:
 1 Steel 3 Stainless steel 5 Fiberglass 8 RMP (SR) 10 Asbestos-cement
 2 Brass 4 Galvanized steel 6 Concrete tile 9 ABS 11 Other (specify) .
 12 None used (open hole)
 SCREEN OR PERFORATION OPENINGS ARE:
 1 Continuous slot 3 Mill slot 5 Gauzed wrapped 8 Saw cut 11 None (open hole)
 2 Louvered shutter 4 Key punched 6 Wire wrapped 9 Drilled holes
 7 Torch cut 10 Other (specify) .
 SCREEN-PERFORATED INTERVALS: From . 65 . ft. to . 85 . ft., From . ft. to . ft.
 From . ft. to . ft., From . ft. to . ft.
 GRAVEL PACK INTERVALS: From . 63 . ft. to . 85 . ft., From . ft. to . ft.
 From . ft. to . ft., From . ft. to . ft.

6 GROUT MATERIAL: 1 Neat cement 2 Cement grout 3 Bentonite 4 Other
 Grout Intervals: From . 0 . ft. to . 59 . ft., From . 59 . ft. to . 63 . ft., From . ft. to . ft.
 What is the nearest source of possible contamination:
 1 Septic tank 4 Lateral lines 7 Pit privy 10 Livestock pens 14 Abandoned water well
 2 Sewer lines 5 Cess pool 8 Sewage lagoon 11 Fuel storage 15 Oil well/Gas well
 3 Watertight sewer lines 6 Seepage pit 9 Feedyard 12 Fertilizer storage 16 Other (specify below)
 13 Insecticide storage
 Direction from well? west How many feet? 30

FROM	TO	LITHOLOGIC LOG	FROM	TO	PLUGGING INTERVALS
0	1	Cly, brn, slty, veg, dry			
1	8	Snd, rd/brn, f-m, tr - mod cly, mod srtd, damp			
8	16.5	Cly, gy/gn, stiff, med plst, tr calc mat, damp, tr blk Fe stain			
16.5	30	Cly, rd/brn, Fe stained, stiff, med plst, damp			
30	60	Cly, lt gn/gy, tr Fe stain, sl sndy, firm, l - med plst, damp			
60	70	Cly, lt gn/brn, stiff, med plst, tr snd, tr wh calc mat, tr blk org mat, damp			
70	80	Cly, mod rd/brn, mod-v sndy, tr wh calc, tr blk org mat, damp, moist, firm, med plst			
					MW1 - Above Grade Cover

7 CONTRACTOR'S OR LANDOWNER'S CERTIFICATION: This water well was (1) constructed, (2) reconstructed, or (3) plugged under my jurisdiction and was completed on (mo/day/year) 08-12-94 and this record is true to the best of my knowledge and belief. Kansas Water Well Contractor's License No. 527 This Water Well Record was completed on (mo/day/yr) 08-17-94 under the business name of GeoCore Services, Inc. by (signature) Doug Ray

INSTRUCTIONS: Use typewriter or ball point pen. PLEASE PRESS FIRMLY and PRINT clearly. Please fill in blanks, underline or circle the correct answers. Send up three copies to Kansas Department of Health and Environment, Bureau of Water, Topeka, Kansas 66620-0001. Telephone: 913-296-5545. Send one to WATER WELL OWNER and retain one for your records.