


1 LOCATION OF WATER WELL: Fraction SW 1/4 NE 1/4 SE 1/4 Section Number 16 Township Number T 27 S Range Number R 13 **(E/W)**
 County: Pratt

Distance and direction from nearest town or city street address of well if located within city?
 1500 feet west of Hwy 281 and 800 feet south of 1st Str.

2 WATER WELL OWNER: Pratt Airport Authority
 RR#, St. Address, Box #: P.O. Box 807 Board of Agriculture, Division of Water Resources
 City, State, ZIP Code: Pratt, Kansas 67124 Application Number:

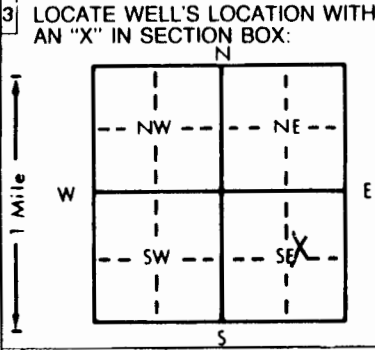

4 DEPTH OF COMPLETED WELL: 65 ft. ELEVATION:
 Depth(s) Groundwater Encountered 1. ft. 2. ft. 3. ft.
 WELL'S STATIC WATER LEVEL: 56.71 ft. below TOC measured on mo/day/yr 08-12-94
 Pump test data: Well water was . ft. after . hours pumping . gpm
 Est. Yield . gpm: Well water was . ft. after . hours pumping . gpm
 Bore Hole Diameter: 7 5/8 in. to 65 ft., and . in. to . ft.
 WELL WATER TO BE USED AS:
 5 Public water supply 8 Air conditioning 11 Injection well
 1 Domestic 3 Feedlot 6 Oil field water supply 9 Dewatering 12 Other (Specify below)
 2 Irrigation 4 Industrial 7 Lawn and garden only **(10) Monitoring well**
 Was a chemical/bacteriological sample submitted to Department? Yes. No. **X**; If yes, mo/day/yr sample was submitted
 Water Well Disinfected? Yes No **X**

5 TYPE OF BLANK CASING USED:
 1 Steel 3 RMP (SR) 5 Wrought iron 8 Concrete tile CASING JOINTS: Glued . Clamped .
(2) PVC 4 ABS 6 Asbestos-Cement 9 Other (specify below) Welded .
 7 Fiberglass Threaded. **X**
 Blank casing diameter . 2 in. to . 45 ft., Dia . in. to . ft., Dia . in. to . ft.
 Casing height above land surface . 30 in., weight . lbs./ft. Wall thickness or gauge No. sch. 40
 TYPE OF SCREEN OR PERFORATION MATERIAL:
 1 Steel 3 Stainless steel 5 Fiberglass **(7) PVC** 10 Asbestos-cement
 2 Brass 4 Galvanized steel 6 Concrete tile 8 RMP (SR) 11 Other (specify) .
 12 None used (open hole)
 SCREEN OR PERFORATION OPENINGS ARE:
 1 Continuous slot **(3) Mill slot** 5 Gauzed wrapped 8 Saw cut 11 None (open hole)
 2 Louvered shutter 4 Key punched 6 Wire wrapped 9 Drilled holes
 7 Torch cut 10 Other (specify) .
 SCREEN-PERFORATED INTERVALS: From . 45 ft. to . 65 ft., From . ft. to . ft.
 From . ft. to . ft., From . ft. to . ft.
 GRAVEL PACK INTERVALS: From . 43 ft. to . 65 ft., From . ft. to . ft.
 From . ft. to . ft., From . ft. to . ft.

6 GROUT MATERIAL: 1 Neat cement **(2) Cement grout** **(3) Bentonite** 4 Other .
 Grout Intervals: From . 0 ft. to . 39 ft., From . 39 ft. to . 43 ft., From . ft. to . ft.
 What is the nearest source of possible contamination:
 1 Septic tank 4 Lateral lines 7 Pit privy **(1) Fuel storage** 14 Abandoned water well
 2 Sewer lines 5 Cess pool 8 Sewage lagoon 12 Fertilizer storage 15 Oil well/Gas well
 3 Watertight sewer lines 6 Seepage pit 9 Feedyard 13 Insecticide storage 16 Other (specify below)
 Direction from well? northeast How many feet? 700

FROM	TO	LITHOLOGIC LOG	FROM	TO	PLUGGING INTERVALS
0	1	Cly, brn slty, veg, dry			
1	6.5	Cly, dk brn, stiff, med plst, damp			
6.5	10	Cly, gy/rd, stiff, med plst, sl-mod sndy, damp			
10	15	Cly, rd/brn, stiff, hi plst, tr wh calc mat, tr blk, org mat, damp			
15	25	Cly, gy/brn, stiff, hi plst, tr snd, tr blk org, sl tr gy calc mat, damp			
25	40	Cly, rd/brn, tr w/gy calc mat, sl tr blk org, firm, med-h plst, damp, tr f snd			
40	50	Cly, lt brn, firm, l plst, mod-f snd, damp			
50	65	Snd, lt brn, v f-f, w srtd, sl tr slt, moist - sat @ 51'			
					MW2 - Above Grade Cover

7 CONTRACTOR'S OR LANDOWNER'S CERTIFICATION: This water well was **(1)** constructed, (2) reconstructed, or (3) plugged under my jurisdiction and was completed on (mo/day/year) 08-12-94 and this record is true to the best of my knowledge and belief. Kansas Water Well Contractor's License No. 527 This Water Well Record was completed on (mo/day/yr) 08-17-94 by (signature) *Doug Roy* under the business name of GeoCore Services, Inc.

INSTRUCTIONS: Use typewriter or ball point pen. PLEASE PRESS FIRMLY and PRINT clearly. Please fill in blanks, underline or circle the correct answers. Send to Kansas Department of Health and Environment, Bureau of Water, Topeka, Kansas 66620-0001. Telephone: 913-296-5545. Send one to WATER WELL OWNER and retain one for your records.