

1 LOCATION OF WATER WELL:	Fraction	Section Number	Township Number	Range Number
County: <u>Pratt</u>	<u>SE</u> $\frac{1}{4}$ <u>SE</u> $\frac{1}{4}$ <u>SE</u> $\frac{1}{4}$	<u>23</u>	<u>T 27</u> <u>S</u>	<u>R 14W</u> <u>EW</u>

Distance and direction from nearest town or city street address of well if located within city?


2 WATER WELL OWNER: Ron SchwerdtfegerRR#, St. Address, Box # : 10437 NW 20th AveCity, State, ZIP Code : Pratt, KS 67124

Board of Agriculture, Division of Water Resources

Application Number:

3 LOCATE WELL'S LOCATION WITH 4 DEPTH OF COMPLETED WELL. 42.5 ft. ELEVATION:

AN "X" IN SECTION BOX:

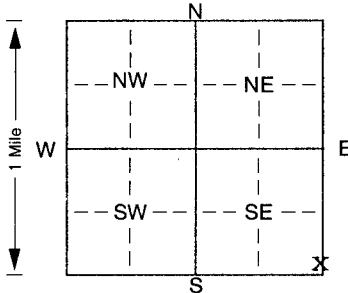

Depth(s) Groundwater Encountered 1. ft. 2. ft. 3. ft.

WELL'S STATIC WATER LEVEL 33.5 ft. below land surface measured on mo/day/yr

Pump test data: Well water was ft. after hours pumping gpm

Est. Yield gpm: Well water was ft. after hours pumping gpm

Bore Hole Diameter. in. to ft., and in. to ft.

WELL WATER TO BE USED AS: 5 Public water supply 8 Air conditioning 11 Injection well

1 Domestic 3 Feedlot 6 Oil field water supply 9 Dewatering 12 Other (Specify below)

2 Irrigation 4 Industrial 7 Domestic (lawn & garden) 10 Monitoring well

Was a chemical/bacteriological sample submitted to Department? Yes. No.; If yes, mo/day/yr sample was submitted

Water Well Disinfected? Yes No

5 TYPE OF BLANK CASING USED: 5 Wrought iron 8 Concrete tile CASING JOINTS: Glued. Clamped.

1 Steel 3 RMP (SR) 6 Asbestos-Cement 9 Other (specify below) Welded.

2 PVC 4 ABS 7 Fiberglass Threaded.Blank casing diameter. in. to 32.5 ft., Dia in. to ft., Dia in. to ft.

Casing height above land surface. in., weight lbs./ft. Wall thickness or gauge No.

TYPE OF SCREEN OR PERFORATION MATERIAL: 7 PVC 10 Asbestos-cement

1 Steel 3 Stainless steel 5 Fiberglass 8 RMP (SR) 11 Other (specify)

2 Brass 4 Galvanized steel 6 Concrete tile 9 ABS 12 None used (open hole)

SCREEN OR PERFORATION OPENINGS ARE: 5 Gauzed wrapped 8 Saw cut 11 None (open hole)

1 Continuous slot 3 Mill slot 6 Wire wrapped 9 Drilled holes

2 Louvered shutter 4 Key punched 7 Torch cut 10 Other (specify) ft.

SCREEN-PERFORATED INTERVALS: From. 32.5 ft. to 42.5 ft., From ft. to ft.

From. ft. to ft., From ft. to ft.

GRAVEL PACK INTERVALS: From. ft. to ft., From ft. to ft.

From. ft. to ft., From ft. to ft.

6 GROUT MATERIAL: 1 Neat cement 2 Cement grout 3 Bentonite 4 Other

Grout Intervals: From. ft. to ft., From ft. to ft., From ft. to ft.

What is the nearest source of possible contamination: 10 Livestock pens 14 Abandoned water well

1 Septic tank 4 Lateral lines 7 Pit privy 11 Fuel storage 15 Oil well/Gas well

2 Sewer lines 5 Cess pool 8 Sewage lagoon 12 Fertilizer storage 16 Other (specify below)

3 Watertight sewer lines 6 Seepage pit 9 Feedyard 13 Insecticide storage

Direction from well? How many feet?

FROM TO LITHOLOGIC LOG FROM TO PLUGGING INTERVALS

4 42.5 Bentonte

Casing was cut off 4' belw ground level and a bag of bentonite was placed over the well casing

7 CONTRACTOR'S OR LANDOWNER'S CERTIFICATION: This water well was (1) constructed, (2) reconstructed, or (3) plugged under my jurisdiction and was

completed on (mo/day/year) 11-16-01 and this record is true to the best of my knowledge and belief. KansasWater Well Contractor's Licence No. 677 This Water Well Record was completed on (mo/day/yr) 01-20-02under the business name of CLT Inc. by (signature) Clint Zyla