

1 LOCATION OF WATER WELL:	Fraction	Section Number	Township Number	Range Number
County: Pratt	NE 1/4 SE 1/4 SE 1/4	36	T 27 S	R 14 W E/W

Distance and direction from nearest town or city street address of well if located within city?

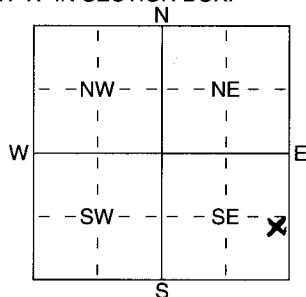
55 NW 30th Avenue Pratt2 WATER WELL OWNER: **Katina G. Griffith**RR#, St. Address, Box # : **55 NW 30th Ave.**City, State, ZIP Code : **Pratt, KS 67124**

Board of Agriculture, Division of Water Resources

Application Number:

3 LOCATE WELL'S LOCATION WITH 4 DEPTH OF COMPLETED WELL **100** ft. ELEVATION:

AN "X" IN SECTION BOX:

Depth(s) Groundwater Encountered **1** ft. 2 ft. 3 ft.WELL'S STATIC WATER LEVEL **47.2** ft. below land surface measured on mo/day/yr **04/06/04**

Pump test data: Well water was ft. after hours pumping gpm

Est. Yield **25** gpm: Well water was ft. after hours pumping gpm

WELL WATER TO BE USED AS: 5 Public water supply 8 Air conditioning 11 Injection well

1 Domestic 3 Feedlot 6 Oil field water supply 9 Dewatering 12 Other (Specify below)

2 Irrigation 4 Industrial 7 Domestic (lawn & garden) 10 Monitoring well

Was a chemical/bacteriological sample submitted to Department? Yes No **X**; If yes, mo/day/yr sample was submitted
Water Well Disinfected? Yes **X** No5 TYPE OF BLANK CASING USED: 5 Wrought iron 8 Concrete tile CASING JOINTS: Glued **X** Clamped

1 Steel 3 RMP (SR) 6 Asbestos-Cement 9 Other (specify below) Welded

2 **PVC** 4 ABS 7 Fiberglass ThreadedBlank casing diameter **5** in. to **80** ft. Dia in. to ft. Dia in. to ft.Casing height above land surface **24** in., weight lbs./ft. Wall thickness or gauge No. **Sch 40**

TYPE OF SCREEN OR PERFORATION MATERIAL:

1 Steel 3 Stainless Steel 5 Fiberglass 7 **PVC** 10 Asbestos-Cement

2 Brass 4 Galvanized Steel 6 Concrete tile 8 RMP (SR) 11 Other (Specify)

SCREEN OR PERFORATION OPENINGS ARE: 5 Gauzed wrapped 8 Saw cut 11 None (open hole)

1 Continuous slot 3 Mill slot **020** 6 Wire wrapped 9 Drilled holes

2 Louvered shutter 4 Key punched 7 Torch cut 10 Other (specify) ft.

SCREEN-PERFORATED INTERVALS: From **80** ft. to **100** ft. From ft. to ft.

From ft. to ft. From ft. to ft.

GRAVEL PACK INTERVALS: From **75** ft. to **100** ft. From ft. to ft.

From ft. to ft. From ft. to ft.

6 GROUT MATERIAL: 1 Neat cement 2 Cement grout 3 **Bentonite** 4 OtherGrout Intervals: From **4** ft. to **30.5** ft. From **66.5** ft. to **75** ft. From ft. to ft.

What is the nearest source of possible contamination:

1 Septic tank 4 Lateral lines 7 Pit privy 10 **Livestock pens** 14 Abandoned water well

2 Sewer lines 5 Cess pool 8 Sewage lagoon 11 Fuel storage 15 Oil well/Gas well

3 Watertight sewer lines 6 Seepage pit 9 Feedyard 12 Fertilizer storage 16 Other (specify below)

Direction from well? **West** How many feet? **999**

FROM TO LITHOLOGIC LOG FROM TO PLUGGING INTERVALS

0 5 Top soil/fine sand 0 4 Top soil

5 60 Fine & medium sand 4 30.5 3/8 Bentonite chips

60 85 Fine sand 30.5 66.5 10/20 Sand

85 100 Medium & coarse sand/gravel 66.5 75 3/8 Bentonite chips

75 100 10/20 Sand

7 CONTRACTOR'S OR LANDOWNER'S CERTIFICATION: This water well was (1) constructed, (2) reconstructed, or (3) plugged under my jurisdiction and was completed on (mo/day/year) **03/26/04** and this record is true to the best of my knowledge and belief. Kansas Water Well Contractor's Licence No **665** This Water Well Record was completed on (mo/day/yr) **04/07/04** under the business name of **Pratt Well Environmental** by (signature) *[Signature]*