

Phone 24

ANDERSEN & DARLING

JACKSON, KANSAS

Hutchinson
—Log Of Test Well—

Pratt

Phone 705

Date of Test

Customer

Wendell Reed

Address

Pratt, Kans.

Location

3 1/2 of NE 1/4 of 28-27-14W

Static Water Level

20'


54 Highway

15 west of intersection
1 1/2 north
of Pratt.

Malheur Formation w/ clay Ballo
throughout. - Should produce Normal
amount of water

chg

60'
63'
70"
75"
80'
144'
148'
152 1/2'

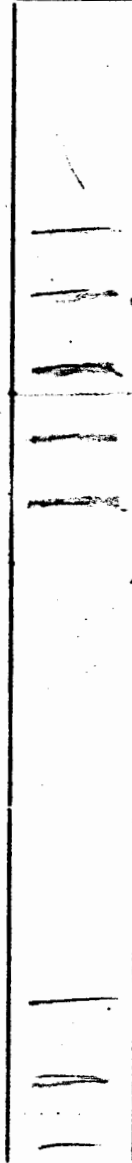

Sandy clay. Not soft
Rocky ledge - 90% Rock - gravel.
sand & clay.
Fine to Med. Sand
Coarse Sand
Med. Gravel
Med to Coarse gravel.
"
"
"
clay & large gravel - solid formation.
mostly clay.
" " Depth of test

By Andersen & Darling Co
Pratt, Kans.