

WATER WELL RECORD

Form WWC-5

Division of Water Resources App. No.


1,703

1 LOCATION OF WATER WELL: County: Pratt	Fraction 1/4 NC 1/4 S2 1/4 NW 1/4	Section Number 31	Township No. T 27 S	Range Number R 14 <input type="checkbox"/> E <input checked="" type="checkbox"/> W
--	---	-----------------------------	-------------------------------	--

Street/Rural Address of Well Location; if unknown, distance & direction from nearest town or intersection: If at owner's address, check here
 Approximately 1 mile north and 9 miles west of Pratt.

Global Positioning System (GPS) information:
 Latitude: **37.65385** (in decimal degrees)
 Longitude: **-98.900331** (in decimal degrees)
 Elevation: **Unknown**
 Datum: WGS 84, NAD 83, NAD 27
 Collection Method:
 GPS unit (Make/Model: **WAAS**)
 Digital Map/Photo, Topographic Map, Land Survey
 Est. Accuracy: <3 m, 3-5 m, 5-15 m, >15 m

2 WATER WELL OWNER: **Ernie Seyfert**
 RR#, Street Address, Box #: **507 Ridgeway Ave.**
 City, State, ZIP Code : **Pratt, KS 67124**

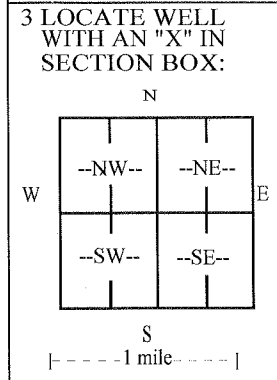

4 DEPTH OF COMPLETED WELL **169.30** ft.

Depth(s) Groundwater Encountered (1) _____ ft. (2) _____ ft. (3) _____ ft.
 WELL'S STATIC WATER LEVEL **76** ft. below land surface measured on mo/day/yr **03/24/14**

Pump test data: Well water was **not checked** ft. after _____ hours pumping _____ gpm
 EST. YIELD _____ gpm. Well water was _____ ft. after _____ hours pumping _____ gpm

Bore Hole Diameter **24** in. to **169** ft., and _____ in. to _____ ft.

WELL WATER TO BE USED AS: Public water supply Geothermal Injection well
 Domestic Feedlot Oil field water supply Dewatering Other (Specify below)
 Irrigation Industrial Domestic-lawn & garden Monitoring well

Was a chemical/bacteriological sample submitted to Department? Yes No
 If yes, mo/day/yr sample was submitted _____
 Water well disinfected? Yes No

5 TYPE OF CASING USED: Steel PVC Other _____

CASING JOINTS: Glued Clamped Welded Threaded Other (Specify) _____

Casing diameter **16** in. to **115** ft., Diameter **16** in. to **135** ft., Diameter **16** in. to **155** ft.
 Casing height above land surface **16** in., Weight **19.75** lbs./ft., Wall thickness or gauge No. **.616**

TYPE OF SCREEN OR PERFORATION MATERIAL:
 Steel Stainless Steel PVC Other (Specify) _____
 Brass Galvanized Steel None used (open hole)

SCREEN OR PERFORATION OPENINGS ARE:
 Continuous slot Mill slot Gauze wrapped Torch cut Drilled holes None (open hole)
 Louvered shutter Key punched Wire wrapped Saw cut Other (specify) _____

SCREEN-PERFORATED INTERVALS: From **115** ft. to **130** ft., From **135** ft. to **151** ft.
 From **155** ft. to **168** ft., From _____ ft. to _____ ft.

GRAVEL PACK INTERVALS: From **22** ft. to **169** ft., From _____ ft. to _____ ft.
 From _____ ft. to _____ ft., From _____ ft. to _____ ft.

6 GROUT MATERIAL: Neat cement Cement grout Bentonite Other _____

Grout Intervals: From **2** ft. to **22** ft., From _____ ft. to _____ ft., From _____ ft. to _____ ft.

What is the nearest source of possible contamination:
 Septic tank Lateral lines Pit privy Livestock pens Insecticide storage Other (specify below) _____
 Sewer lines Cesspool Sewage lagoon Fuel storage Abandoned water well **None Known**
 Watertight sewer lines Seepage pit Feedyard Fertilizer storage Oil well/gas well _____

Direction from well _____ Distance from well _____

FROM	TO	LITHOLOGIC LOG	FROM	TO	LITHO. LOG (cont.) or PLUGGING INTERVALS
0	5	Topsoil	151	155	Clay, white, brown, caliche
5	67	Clay, brown, gray, soft	155	168	Sand & gravel, fine to coarse
67	77	Clay, tan, sandy	168	169	Clay, gray
77	90	Clay, gray, caliche			
90	103	Sand & gravel, fine to coarse			
103	110	Clay, tan & brown, sandy			
110	130	Sand & gravel, fine to coarse			
130	133	Clay, tan			
133	140	Sand & gravel, fine to coarse, clay streak			
140	151	Sand & gravel, fine to coarse			

7 CONTRACTOR'S OR LANDOWNER'S CERTIFICATION: This water well was constructed, reconstructed, or plugged under my jurisdiction and was completed on (mo/day/year) **03/24/14** and this record is true to the best of my knowledge and belief.
 Kansas Water Well Contractor's License No. **185** This Water Well Record was completed on (mo/day/year) **04/03/14**
 under the business name of **Clarke Well & Equipment, Inc.** by (signature) _____

INSTRUCTIONS: Use typewriter or ball point pen. PLEASE PRESS FIRMLY and PRINT clearly. Please fill in blanks and check the correct answers. Send three copies (white, blue, pink) to Kansas Department of Health and Environment, Bureau of Water, Geology Section, 1000 SW Jackson St., Suite 420, Topeka, Kansas 66612-1367. Telephone 785-296-5522. Send one copy to WATER WELL OWNER and retain one for your records. Include fee of \$5.00 for each constructed well. Visit us at <http://www.kdheks.gov/waterwell/index.html>.