


WATER WELL RECORD Form WWC-5

Division of Water Resources App. No. [] Well ID []

Original Record Correction Change in Well Use

1 LOCATION OF WATER WELL: County: Pratt Fraction NE 1/4 SE 1/4 NE 1/4 SE 1/4 Section Number 1 Township Number T 27 S Range Number R 14 E W

2 WELL OWNER: Last Name: Dauner First: John Street or Rural Address where well is located (if unknown, distance and direction from nearest town or intersection): If at owner's address, check here: [] NW 40th Ave & NW 30th Ave intersection, 1 1/2 miles Northwest of road 200'

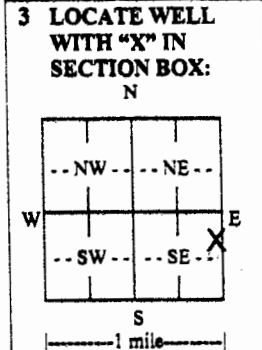

3 LOCATE WELL WITH 'X' IN SECTION BOX: N W E S 1 mile

4 DEPTH OF COMPLETED WELL: 140 ft. Depth(s) Groundwater Encountered: 1) 63 ft. 2) ... ft. 3) ... ft. or 4) Dry Well WELL'S STATIC WATER LEVEL: 63 ft. below land surface, measured on (mo-day-yr) 07/21/2016 above land surface, measured on (mo-day-yr) ... Pump test data: Well water was ... ft. after ... hours pumping ... gpm Well water was ... ft. after ... hours pumping ... gpm Estimated Yield: 50 gpm Bore Hole Diameter: 10 in. to 140 ft. and ... in. to ... ft.

5 Latitude: 37.724232 (decimal degrees) Longitude: 98.793807 (decimal degrees) Datum: WGS 84 NAD 83 NAD 27 Source for Latitude/Longitude: GPS (unit make/model: ...) (WAAS enabled? Yes No) Land Survey Topographic Map Online Mapper: ...

6 Elevation: 1979 ft. Ground Level TOC Source: Land Survey GPS Topographic Map Other KQLAR

7 WELL WATER TO BE USED AS:

1. Domestic: Household Lawn & Garden Livestock Irrigation Feedlot Industrial

5. Public Water Supply: well ID ... Dewatering: how many wells? ... Aquifer Recharge: well ID ... Monitoring: well ID ... Air Sparge Soil Vapor Extraction Recovery Injection

10. Oil Field Water Supply: lease ... Test Hole: well ID ... Cased Uncased Geotechnical Geothermal: how many bores? ... a) Closed Loop Horizontal Vertical b) Open Loop Surface Discharge Inj. of Water Other (specify): ...

Was a chemical/bacteriological sample submitted to KDHE? Yes No If yes, date sample was submitted: ... Water well disinfected? Yes No

8 TYPE OF CASING USED: Steel PVC Other CASING JOINTS: Glued Clamped Welded Threaded Casing diameter 6 in. to 140 ft. Diameter ... in. to ... ft. Diameter ... in. to ... ft. Casing height above land surface 18 in. Weight ... lbs./ft. Wall thickness or gauge No. SDR17

TYPE OF SCREEN OR PERFORATION MATERIAL: Steel Stainless Steel Fiberglass PVC Other (Specify) ... Brass Galvanized Steel Concrete tile None used (open hole)

SCREEN OR PERFORATION OPENINGS ARE: Continuous Slot Mill Slot Gauze Wrapped Torch Cut Drilled Holes Other (Specify) ... Louvered Shutter Key Punched Wire Wrapped Saw Cut None (Open Hole)

SCREEN-PERFORATED INTERVALS: From 100 ft. to 140 ft. From ... ft. to ... ft. From ... ft. to ... ft.

GRAVEL PACK INTERVALS: From 20 ft. to 140 ft. From ... ft. to ... ft. From ... ft. to ... ft.

9 GROUT MATERIAL: Neat cement Cement grout Bentonite Other Grout Intervals: From 0 ft. to 20 ft. From ... ft. to ... ft. From ... ft. to ... ft.

Nearest source of possible contamination: Septic Tank Lateral Lines Pit Privy Livestock Pens Insecticide Storage Sewer Lines Cess Pool Sewage Lagoon Fuel Storage Abandoned Water Well Watertight Sewer Lines Seepage Pit Feedyard Fertilizer Storage Oil Well/Gas Well Other (Specify) ...

Direction from well? N/A Distance from well? N/A ft.

10 FROM	TO	LITHOLOGIC LOG	FROM	TO	LITHO. LOG (cont.) or PLUGGING INTERVALS
0	20	Top soil. Brown/tan clay. Fine sand.			
20	40	Tan/brown clay. Fine sand.			
40	55	Tan sand.			
55	80	Fine medium sand. Small gravel.			
80	96	White/tan/brown clay.			
96	105	Fine coarse sand.			
105	115	Tan/brown clay.			
115	130	Coarse sand. Small medium gravel.			
130	140	Fine coarse sand w/brown clay.			

11 CONTRACTOR'S OR LANDOWNER'S CERTIFICATION: This water well was constructed, reconstructed, or plugged under my jurisdiction and was completed on (mo-day-year) 07/21/2016 and this record is true to the best of my knowledge and belief. Kansas Water Well Contractor's License No. 846 This Water Well Record was completed on (mo-day-year) 07/25/2018 under the business name of Nash Water Well Service, LLC